

Greenwood
Form 51-5M-1-30-38840

KANSAS

Map No. _____ Sec. 11 Twp. 25 R. 8

Well No. 5 Truckgraber Farm
Plains Oil Company

NORTH

WEST

EAST

SOUTH

Location _____
Drilling Remarks _____

Rig Up _____
Drilling Remarks

RECORD

Cased _____ in. _____ ft.

Sand

Gas

Oil

Total Depth_____

PRODUCTION

1st 24 hrs. Nat. _____

1st 24 hrs. after shot_____

Gas _____ cu. ft. _____

Dry Hole

Abandoned_____

Map No. _____ Sec. 11 Twp. 25 R. 8E


Well No. 5 Tubgraver Farm
Plains oil Company

250 Ft. from N. Line

_____ Ft. from S. Line

250 Ft. from E. Line

_____ Ft. from W. Line

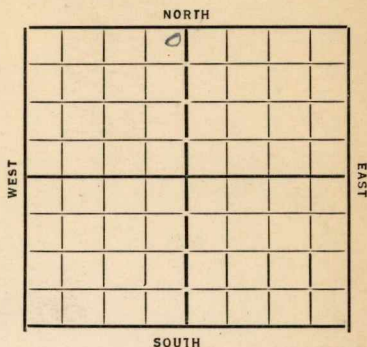

Date
1933

REPORT

6/21 machine

6/28 Rgn up

7/5 apud

7/12 drlg 850'

7/19 " 1400

7/26 drlg 2151'

8/2 Top Siliceous

8/2 Sand 2317-38 T.D. 2338

shot 40 gts

Est 50 bbls

COMPLETE

KANSAS

Map No. 15 Sec. 11 Twp. 25 R. 8 EWell No. 5 TrickgravesPlains Oil

Company

Contractor

NE NW NE

SECTION PLAT

		<u>0</u>	

250 Ft. from N. Line

Ft. from S. Line

250 Ft. from E. Line

Ft. from W. Line

FIRST REPORTS

Location

Rig up

Drilling and Remarks:

machine

RECORD

Cased.....in.,ft.

Sand.....

Gas.....

Oil.....

Total Depth.....

PRODUCTION

1st 24 hrs. Nat.....

1st 24 hrs. after shot.....

Gas.....Cu. Ft.

Dry Hole.....

Abandoned.....

Date

6/21/33 192 Oval Mennschick Scout

Map No. 15 Sec. 11 Twp. 25 R. 8EWell No. 5- Truckgraverplains Company

Contractor

SECTION PLAT

250 Ft. from N. Line

Ft. from S. Line

250 Ft. from E. Line

Ft. from W. Line

COMPLETED

Location.....

Rig up.....

Drilling and Remarks:

Sand 2317-38
shot 40 gts

Est 50 bbls

RECORD

Cased.....in.,ft.

Sand.....

Gas.....

Oil.....

Total Depth 2338

PRODUCTION

1st 24 hrs. Nat.....

1st 24 hrs. after shot.....

Gas.....Cu. Ft.

Dry Hole.....

Abandoned.....

Date

8/7/33 192 O. Munnich Scout