


Map No. Kan Sec. 12 Twp. 25 R. 8
Well No. 6 Birkett Farm
C.R.oth Company

NORTH

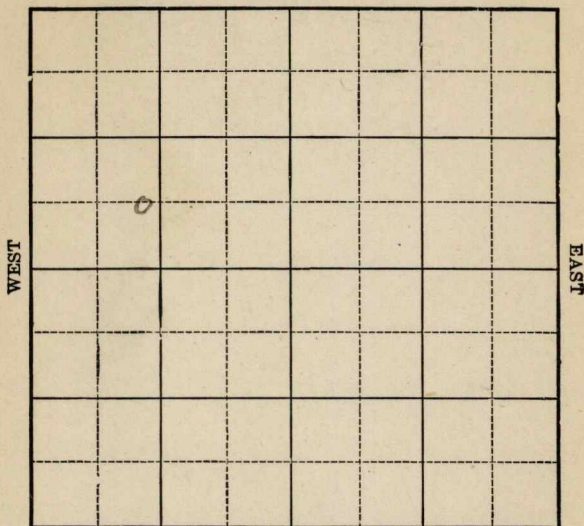

SOUTH

Location _____

Drilling Remarks

Rig Up.....

Drilling Remarks

RECORD

Cased _____ in. _____ ft.

Sand

Gas

Oil

Total Depth.....

PRODUCTION

1st 24 hrs. Nat.-----

1st. 24 hrs. after shot_____

Gas _____ cu. ft.

Dry Hole.....


Abandoned

Map No. *Kan.* Sec. *12* Twp. *25* R. *8*Well No. *6* *Burket* Farm
C. E. Roth et al Company

Ft. from N. Line

660 Ft. from S. Line

Ft. from E. Line

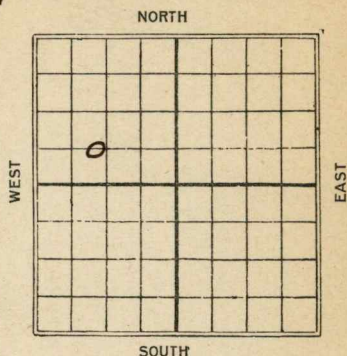1120 Ft. from W. Line*C*

Date

REPORT

*1925**7/3* *Rign up**7/10* *Spud.**7/17* *S.D. 1200**7/24* *_____**7/31* *_____**8/7* *sand 2280-2295**30/50 lbs*

Map No. 15 Sec. 12 Twp. 25 R. 8

Well No. 6

O. E. Roth & Co Company

Contractor

FIRST REPORTS

Ft. from N. Line

660 Ft. from S. Line

Ft. from E. Line

1120 Ft. from W. Line

SECTION PLAT

o			

Location

Rig up

Drilling and Remarks:

Rigging up.

RECORD

Cased _____ in., _____ ft.

Sand _____

Gas _____

Oil _____

Total Depth _____

PRODUCTION

1st 24 hrs. Nat. _____

1st 24 hrs. after shot _____

Gas _____ Cu. Ft.

Dry Hole _____

Abandoned _____

Date

JUL 3 1925

192

CHAS. L. SHERWOOD

Scout

Map No. 15 Sec. 12 Twp. 25 R. 8Well No. 6 BurgettC. E. Roth & Co Company

Contractor

COMPLETED

SECTION PLAT

660 Ft. from N. Line660 Ft. from S. Line1120 Ft. from E. Line1120 Ft. from W. Line

6			

Location

Rig up

Drilling and Remarks:

30/50 bhs.

RECORD

Cased 2280-2295' in., ft.

Sand

Gas

Oil

Total Depth 2295'

PRODUCTION

1st 24 hrs. Nat.

1st 24 hrs. after shot

Gas Cu. Ft.

Dry Hole

Abandoned

Date

AUG 7 1925

192

CHAS. L. SHERWOOD

Scout