

Section 36 Township 26 Range 5E

Well No. #1 Sluss

Company Rex & Morris

Miscellaneous

NORTH

WEST

EAST


						0	

SOUTH

Sec. 36 **KANSAS** Twp. 26 R. 5E

Well No. #1 Sluss Farm _____
Rex & Morris Company _____

_____ Ft. from N. Line
990 Ft. from S. Line
990 Ft. from E. Line
_____ Ft. from W. Line

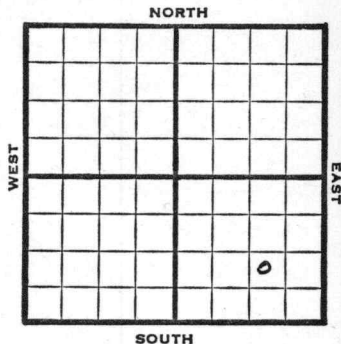

1947	Elev. 1354' REPORT
10/29	Location
11/5	"
11/12	"
11/19	Drlg. 600'
11/25	13" @ 860' Drlg. 1370'
12/3	10" @ 1625' Lansing 1822' Drlg. 1985'
12/10	8" @ 2012' KC 2140' BKC 2330' Drlg. 2400'
12/17	Mississippi 2763' TD 2794'

ABANDONED

Map No. _____ Sec. 36 Twp. 26 R. 5E

Well No. 1 Sluss

Rex & Morris Company

FIRST REPORT Contractor

NW SE SE

SECTION PLAT

_____ Ft. from N. Line

990

_____ Ft. from S. Line

990

_____ Ft. from E. Line

_____ Ft. from W. Line

			5

Butler County

Location X

Rig up _____

Drilling and Remarks:

RECORD

Cased _____ in., _____ ft.

Sand _____

Gas _____

Oil _____

Total Depth _____

PRODUCTION

1st 24 hrs. Nat. _____

1st 24 hrs. after shot _____

Gas _____ Cu. Ft.

Dry Hole _____

Abandoned _____

Date

OCT 29 1947 19

S. J. LEWIS Scout

