


Map No. K Sec. 12 Twp. 25 R. 8Well No. 2 Burkett Farm
Roth & Farout Company

Ft. from N. Line

1120 Ft. from S. Line1120 Ft. from E. Line

Ft. from W. Line

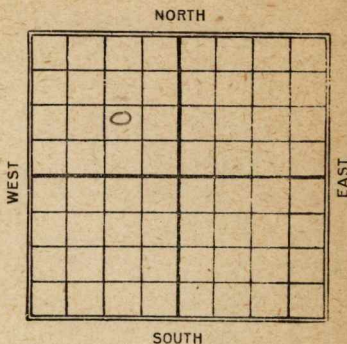

Date

REPORT

192411/12Dlg 2100'11/19Setting 6" @ 210011/26Top sand 2237 Pay 2240-46T.D. 2261 20 gts 20 Bbls

15 KANSAS
 Map No. _____ Sec. 12 Twp. 25 R. 8

Well No. #2 — Burkett

Roth & Farout Company

Contractor

FIRST REFORMATION

SECTION PLAT

_____ Ft. from N. Line

1120 Ft. from S. Line

1120 Ft. from E. Line

_____ Ft. from W. Line

	○		

Location _____

Rig up _____

Drilling and Remarks:

D. 2100'

RECORD

Cased _____ in., _____ ft.

Sand _____

Gas _____

Oil _____

Total Depth _____

PRODUCTION

1st 24 hrs. Nat. _____

1st 24 hrs. after shot _____

Gas _____ Cu. Ft.

Dry Hole _____

Abandoned _____

Date

NOV 12 1924

192

M. A. BENEAR

Scout

15 **KANSAS** Map No. _____ Sec. 12 Twp. 25 R. 8

Well No. #2 Burkett
Rath & Tarant Company

Contractor

COMPLETED SECTION PLAT

_____ Ft. from N. Line

1120 Ft. from S. Line

1120 Ft. from E. Line

_____ Ft. from W. Line

	0		

Location _____

Rig up _____

Drilling and Remarks:

Tap. 1. 2237
Pay 2240-46
T.D. 2261
20/20

RECORD

Cased _____ in., _____ ft.

Sand _____

Gas _____

Oil _____

Total Depth _____

PRODUCTION

1st 24 hrs. Nat. _____

1st 24 hrs. after shot _____

Gas _____ Cu. Ft.

Dry Hole _____

Abandoned _____

Date

M. A. BENEAR

NOV 26 1924

192

Scout