
Form 51 5M 8-24 19567

Map No. Kansas Sec. 12 Twp. 25 R. 8

Well No. 4 Birkett Farm

Roth + Faraut Company

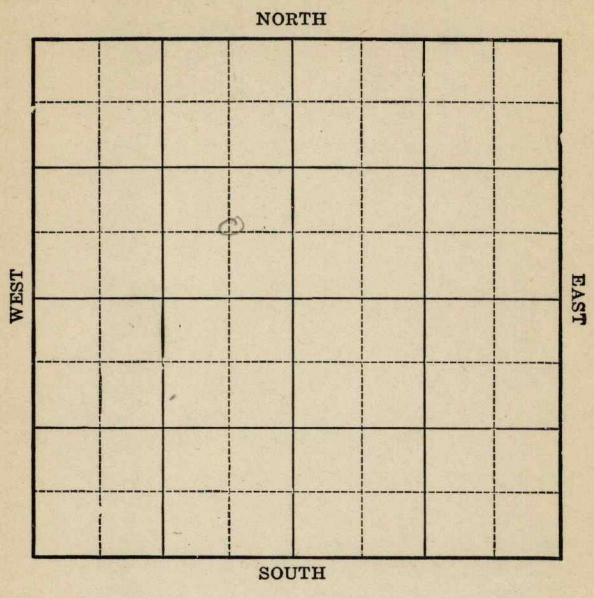

Location

Drilling Remarks

Rig Up

Drilling Remarks

RECORD

Cased in. ft.

Sand

Gas

Oil

Total Depth

PRODUCTION

1st 24 hrs. Nat.

1st. 24 hrs. after shot

Gas cu. ft.

Dry Hole


Abandoned

Form 252A 5M 8-24 16529

Map No. Kansas Sec. 12 Twp. 25 R 8

Well No. 4 Burkett Farm

Roth + Faroutt Company

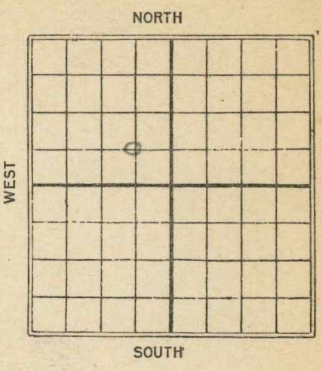

____ Ft. from N. Line

660 Ft. from S. Line

660 Ft. from E. Line

____ Ft. from W. Line

Date 1923	REPORT
3/1	Spud
3/30	2275-2285 T.D. 2311
	25 qts 15 Bbls

Form 26—1M Bks.—3-23—11959.

Map No. 15 KANSAS Sec. 12 Twp. 25 R. 8


Well No. 4 Birkett

Rath & Farrant Company

Contractor

FIRST REPORT

SECTION PLAT

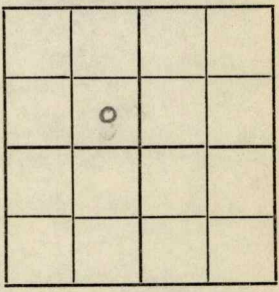

_____Ft. from N. Line

660 Ft. from S. Line

660 Ft. from E. Line

_____Ft. from W. Line

Location _____

Rig up _____

Drilling and Remarks:

Spud.

RECORD

Cased _____ in., _____ ft.

Sand _____

Gas _____

Oil _____

Total Depth _____

PRODUCTION

1st 24 hrs. Nat. _____

1st 24 hrs. after shot _____

Gas _____ Cu. Ft.

Dry Hole _____

Abandoned _____

Date

3/1 1925

M. A. BENEAR Scout

Form 26—1M Bks.—3-23—11959.

Map No. 15 KANSAS Sec. 12 Twp. 25 R. 8


Well No. 4 Birkett

Kathe & Farrantt Company

Contractor

COMPLETED

SECTION PLAT

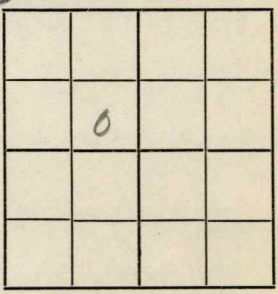

Ft. from N. Line

660' Ft. from S. Line

660' Ft. from E. Line

Ft. from W. Line

Location

Rig up

Drilling and Remarks:

shot 25 qts,

RECORD

Cased in., ft.

Sand 2275 - 2285

Gas

Oil

Total Depth 2311

PRODUCTION

1st 24 hrs. Nat.

1st 24 hrs. after shot 13

Gas Cu. Ft.

Dry Hole

Abandoned

Date

3/30 1925

M. A. BENEAR Scout