


Section 36 Township 26 Range 5-E

Well No. #2 Hamilton

Company Rex & Morris

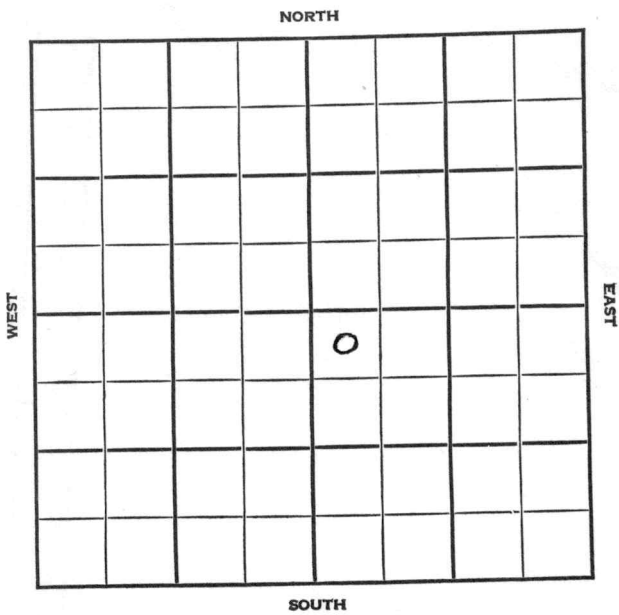

KANSAS

Butler

Sec. 36 Twp. 26 R. 5E

Well No. #2 Hamilton Farm

Rex & Morris Company

Miscellaneous


330' Ft. from N. Line

\_\_\_\_\_ Ft. from S. Line

\_\_\_\_\_ Ft. from E. Line

330' Ft. from W. Line

NW SE

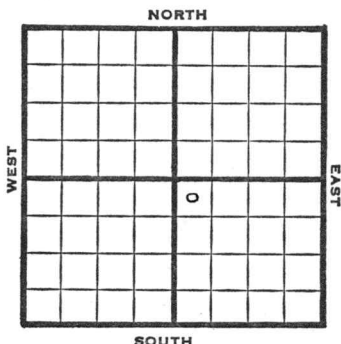

1948

Elev. 1341' REPORT

5/5 Machine

5/12 Drlg. 230'

5/19 13" @ 710'  
Drlg. 915'

6/1 Bart 2739'  
Miss 2755'  
TD 2780'

**ABANDONED**

Map No. 14 Sec. 36 Twp. 26 R. 5E

Well No. 2 Hamilton

Rex & Morris Company

**ABANDONED** Contractor

NW SE

E. 1341  
SECTION PLAT

330 Ft. from N. Line

\_\_\_\_\_ Ft. from S. Line

\_\_\_\_\_ Ft. from E. Line

330 Ft. from W. Line

		0	

Butler County

Location \_\_\_\_\_

Rig up \_\_\_\_\_

Drilling and Remarks:

*Bar 72739*

*Mis 2755*

RECORD

Cased \_\_\_\_\_ in., \_\_\_\_\_ ft.

Sand \_\_\_\_\_

Gas \_\_\_\_\_

Oil \_\_\_\_\_

Total Depth 2750

PRODUCTION

1st 24 hrs. Nat. \_\_\_\_\_

1st 24 hrs. after shot \_\_\_\_\_

Gas \_\_\_\_\_ Cu. Ft.

Dry Hole \_\_\_\_\_

Abandoned \_\_\_\_\_

Date

JUN 1 1948 19

S. J. LEWIS Scout

Map No. \_\_\_\_\_ Sec. 36 Twp. 26 R. 5E

Well No. 2 Hamilton

Rex & Morris Company

FIRST REPORT Contractor

NW SE

SECTION PLAT

330 Ft. from N. Line

\_\_\_\_\_ Ft. from S. Line

\_\_\_\_\_ Ft. from E. Line

330 Ft. from W. Line

		o	

Butler County

Location \_\_\_\_\_

Rig up \_\_\_\_\_

Drilling and Remarks:

Machine

RECORD

Cased \_\_\_\_\_ in., \_\_\_\_\_ ft.

Sand \_\_\_\_\_

Gas \_\_\_\_\_

Oil \_\_\_\_\_

Total Depth \_\_\_\_\_

PRODUCTION

1st 24 hrs. Nat. \_\_\_\_\_

1st 24 hrs. after shot \_\_\_\_\_

Gas \_\_\_\_\_ Cu. Ft.

Dry Hole \_\_\_\_\_

Abandoned \_\_\_\_\_

Date

MAY 5 1948 19\_\_\_\_\_

S. J. LEWIS Scout