


Map No. _____ Sec. 13 Twp. 25 R. 8
 Well No. 3-Welch Farm _____
Loth & Faurat Company

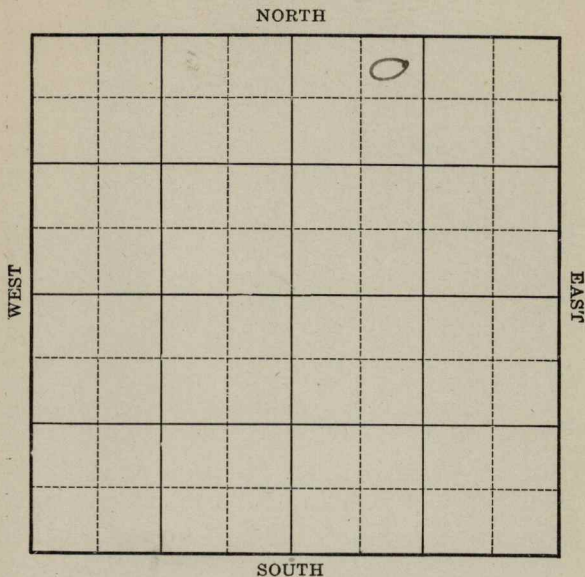

Location _____

Drilling Remarks _____

Rig Up _____

Drilling Remarks _____

RECORD

Cased _____ in. _____ ft.

Sand _____

Gas _____

Oil _____

Total Depth _____

PRODUCTION

1st 24 hrs. Nat. _____

1st 24 hrs. after shot _____

Gas _____ cu. ft.

Dry Hole _____

Abandoned _____

Map No. _____ Sec. 13 Twp. 25 R. 8
 Well No. 3 - Welch Farm
Roth & Faurat Company

NORTH

330 Ft. from N. Line


_____ Ft. from S. Line

_____ Ft. from E. Line

990 Ft. from W. Line

WEST

EAST

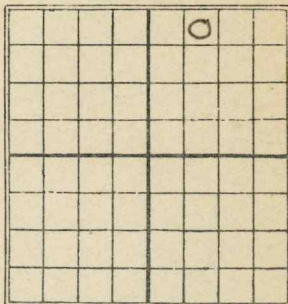

SOUTH

1927

Date

REPORT

9/7 Drilg 1500'
9/14 2376-2394
T.D. 2394
30/25 bbb

Sherwood *E*
 15 **KANSAS** 13 Twp. 25 R. 8
 Map No. Sec. Twp. R.
 Well No. 3 Welch
 Roth & Laurat Company

Contractor

FIRST REPORTS**SECTION PLAT**

220 Ft. from N. Line

Ft. from S. Line

Ft. from E. Line

990 Ft. from W. Line

		0	

Location

Rig up

Drilling and Remarks:

29 1500'

RECORD

Cased in., ft.

Sand

Gas

Oil

Total Depth

PRODUCTION

1st 24 hrs. Nat.

1st 24 hrs. after shot

Gas Cu. Ft.

Dry Hole

Abandoned

Date

SEP 7 - 1927

CHAS. L. SHERWOOD

192

Scout

15 **KANSAS** Sec. 13 Twp. 25 R. 8

Well No. 3 Welch
Lath & Zaurat Company

Contractor

COMPLETED

SECTION PLAT

330 Ft. from N. Line

----- Ft. from S. Line

----- Ft. from E. Line

990 Ft. from W. Line

		0	

Location -----

Rig up -----

Drilling and Remarks:

RECORD

Cased ----- in., ----- ft.

Sand 2376-2394

Gas -----

Oil -----

Total Depth 2394

PRODUCTION

1st 24 hrs. Nat. -----

1st 24 hrs. after shot -----

Gas ----- Cu. Ft.

Dry Hole -----

Abandoned -----

Date

SEP 14 1927

192

CHAS. L. SHERWOOD

Scout