


Butler

Form 51-5M-2-29-34703

Map No. KANSAS Sec. 30 Twp. 26 R. 5E

Well No. 67-500620 Farm Magnolia Pet Company

NORTH

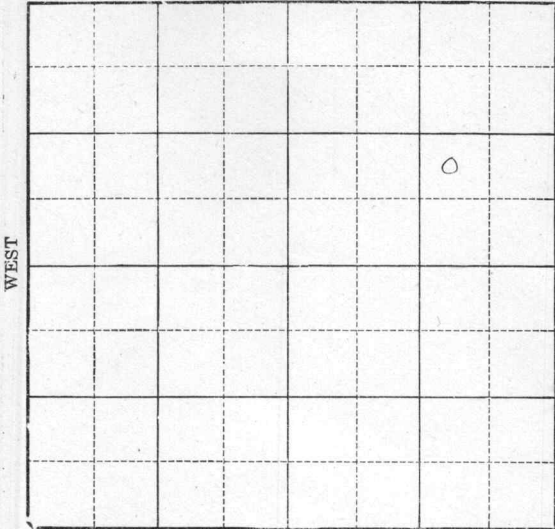

SOUTH

Location _____

Drilling Remarks _____

Rig Up _____

Drilling Remarks _____

RECORD

Cased _____ in. _____ ft.

Sand _____

Gas _____

Oil _____

Total Depth _____

PRODUCTION

1st 24 hrs. Nat. _____

1st 24 hrs. after shot _____


Gas _____ cu. ft.

Dry Hole _____

Abandoned _____

Map No. KANSAS Sec. 30 Twp. 26 R. 5^E
 Well No. 67-700gln Farm
Magnolia Pet Company

 Ft. from N. Line
940 Ft. from S. Line
990 Ft. from E. Line
 Ft. from W. Line
1931

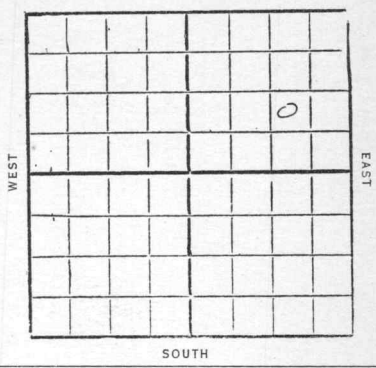

Date	REPORT
8/5	Log
8/12	Bldg rig
8/19	Run up
8/26	1 Blg 450'
9/2	" 1020'
9/9	Dred 10" - 1702
	Dred 1750'
9/16	Dred 8" - 2320'
9/23	Dred 2640'
9/30	Land 2614-50
	TD 2650
	Pay 2619-40
	shot 80 qt 2619-40
	50 lbs oil
	Comp.

Butler

14 KANSAS Sec. 30 Twp. 26 R. 5^E

Map No. _____

Well No. *67 Kessler* _____

Magnolia Gas Co _____ Company

_____ Contractor

FIRST REPORTS

_____ Ft. from N. Line

990 Ft. from S. Line

990 Ft. from E. Line

_____ Ft. from W. Line

SECTION PLAT

			o

Location _____

Rig up _____

Drilling and Remarks:

Progs

RECORD

Cased _____ in., _____ ft.

Sand _____

Gas _____

Oil _____

Total Depth _____

PRODUCTION

1st 24 hrs. Nat. _____

1st 24 hrs. after shot _____

Gas _____ Cu. Ft.

Dry Hole _____

Abandoned _____

Date

AUG 5 1931 CHAS. L. SHERWOOD

14

Butler

E

Map No. KANSAS Sec. 30 Twp. 26 R. 5

Well No. 67 Keagler

Magnolia pits Co Company

Contractor

COMPLETED

SECTION PLAT

..... Ft. from N. Line

990 Ft. from S. Line

990 Ft. from E. Line

..... Ft. from W. Line

			0

Location.....

Rig up.....

Drilling and Remarks:

Pay 2619-40
80/ 2619-40
50 Bls.

RECORD

Cased..... in., ft.

Sand 2614-2650

Gas.....

Oil.....

Total Depth 2650

PRODUCTION

1st 24 hrs. Nat.....

1st 24 hrs. after shot.....

Gas..... Cu. Ft.

Dry Hole.....

Abandoned.....

Date

SEP 30 1931 CHAS. L. SHERWOOD