


Section 13 Township 25 Range 8E

Well No. #1 Welsh

Company Nadel & Gussman

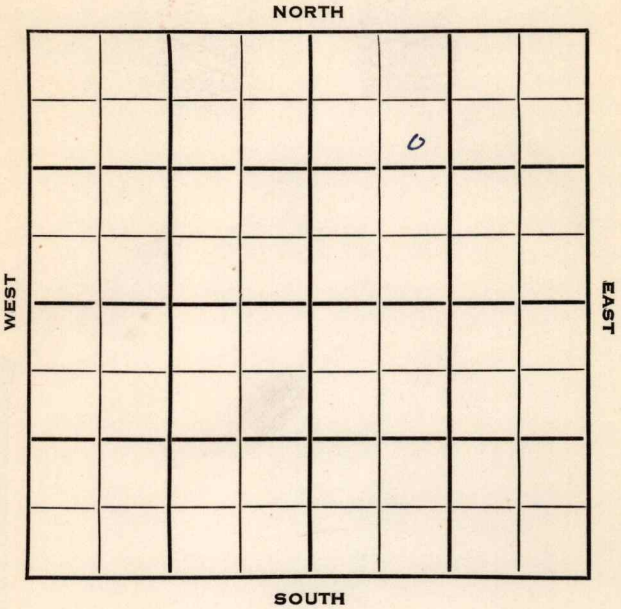

Greenwood

KANSAS ✓

Sec. 13 Twp. 25 R. 8EWell No. #1 Welsh FarmNadel & Gussman Company

Contractor


990 Ft. from N. Line

Ft. from S. Line

Ft. from E. Line

990 Ft. from W. Line

SE NW NE

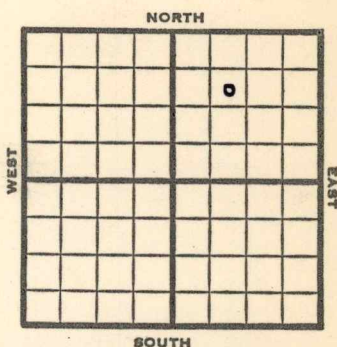

1953 Elev. - REPORT

2/4 RUCT
 3/4 Spud 2-7-53
 Oil Well
 TD 2442
 10" @ 1045
 8" @ 1500
 Sd 2370-2408
 5" @ 2376
 TD 2442
 PB 2408
 S/40 bopd
 Comp. 25 bopd

COMPLETED

County Greenwood State Kansas

Sec. 13 (Blk.) 25 (Sur.) 8E Map No.

Operator **Nadel & Gussman**

Well No. 1 Farm Welsh

Elev.	Location	SE NW NE
-------	----------	-----------------

[illegible]

990 Ft. From N Line NE

990 Ft. From **V** Line Quarter

1st. Report FEB 4 1953

Completion

Remarks

Spudding Date _____

Drlg. Data

R U C T

J. G. McGEHEE