


Section 13 Township 25 Range 8E

Well No. #10 Welch

Company Nadel & Gussman

NORTH

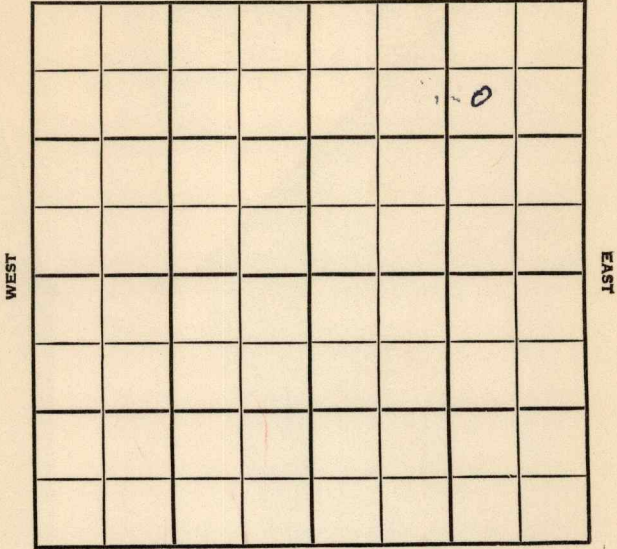

SOUTH

Greenwood

KANSAS

SEC. TWP. R.

WELL NO. 13 25 8 E

COMPANY # 10 Welsh FARM

CONTRACTOR Nadel & Gussman


Cox & Burns

990 Wilkerson Pool Ft. from N. Line

Ft. from S. Line

990 Ft. from E. Line

Ft. from W. Line

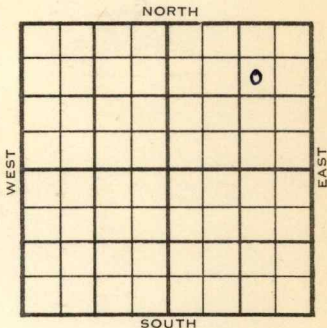

SW NE NE

ELEVATION

REPORT

1954

-

5/12

RUCT

6/9

Spud 5-13-54
13" @ 30'
Bart 2415'
TD 2479'
D&A

ABANDONED

