


DX 78-1 Greenwood

KANSAS

Section 13 Township 25S Range 8E

Well No. #11 Welsh

Company Nadel & Gussman

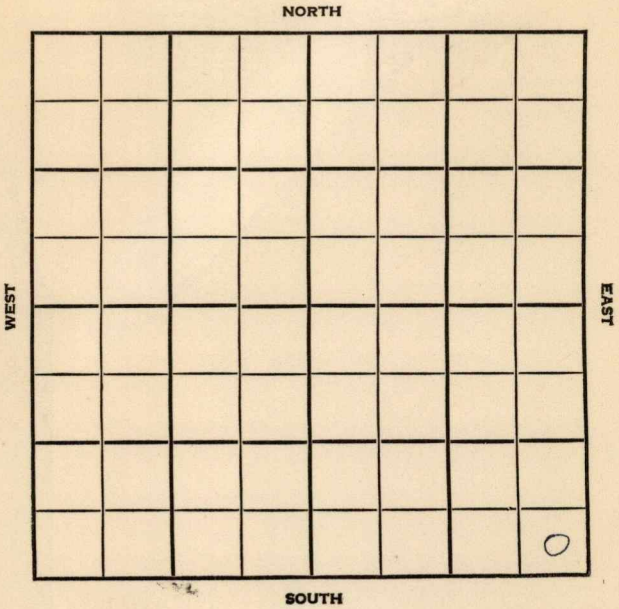


SEC. 13	TWP. 25	R. 8E
------------	------------	----------

WELL NO. #11 Welsh FARM

COMPANY Nadel & Gussman

CONTRACTOR Earl Sauder  
Teichgraber

\_\_\_\_\_ FT. FROM N. LINE  
~~330~~ \_\_\_\_\_ FT. FROM S. LINE  
~~600~~ \_\_\_\_\_ FT. FROM E. LINE  
 \_\_\_\_\_ FT. FROM W. LINE

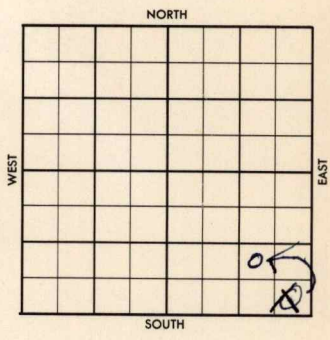

~~SE SE SE~~  
NW

1956	ELEVATION	REPORT
------	-----------	--------

8-1 Comm. 7-17-56  
 10" @ 930  
 8" @ 1527  
 Drlg. 1535

**COMPLETED**

County Greenwood Elev. \_\_\_\_\_  
 Sec. 13 Twp. 25S Rge. 8E  
 Company Nadel & Gussman  
 Farm Name Welsh No. 11

TOPS	DEPTH	LOG	DATUM	Loc. in Sec.
Anh.				SE SE SE
Tp.				600' FEL x
H.				330' FSL
Tr.				
Dg.				
Bl.				
L.				Geol. _____
K.C.				Contr. _____
B.K.C.				Earl Sauder
Ce.				
C.				Pool
M.				Teichgraber
M.				
K.				
Mz.				
Mq.				
V.				
S.				
S.				
A.				
R.				
Pe.				
G.				
T.D.				

FIRST REPORT

Date Comm. 7-17-56 AUG 1 1956  
10" 930; 8" 1527; D 1535

*310*

PLANNED 1956

Co.  
Sec.  
No.  
T.  
R.

CORRECTION

CORRECTION

FORM 513 SUNRAY

County Greenwood Elev. 1417 est Grd  
 Sec. 13 Twp. 25S Rge. 8E  
 Company Nadel & Gussman  
 Farm Name Welsh No. 11

TOPS	DEPTH	LOG	DATUM	Log/Sec.
Anh.				SE SE SE
Tr.	<u>2367-75</u>			600' PBL X
Dg.	<u>2470</u>			330' PBL
Bl.				
L.				Geol.
K.C.				Contr.
B.K.C.				Earl Sauder
Ce.				
C.				Pool
M.				Teichgraber
M.				
K.				
Mz.				
Ma.				
V.				
S.				
S.				
A.				COMPLETE
R.				
Pe.				SEP 12 '56
G.				
T.D.	<u>2473</u>			

Date Comm. 7-17-56  
 10" 930; 8" 1527; D 1535 AUG 8 '56 7" @  
 2141 ID 2425 AUG 15 '56  
 4 1/2 @ 2470 / 75 GO AUG 22 '56 DD  
 2495 PB 2430 50 / 2367-75  
 not st Fiac 6x8 AUG 29 '56 SEP 5 '56  
 SEP 12 '56 P. 10 Bopd + 5 Bwpd.