


Section 30 Township 26 Range 5EWell No. #97 KooglerCompany Magnolia

NORTH

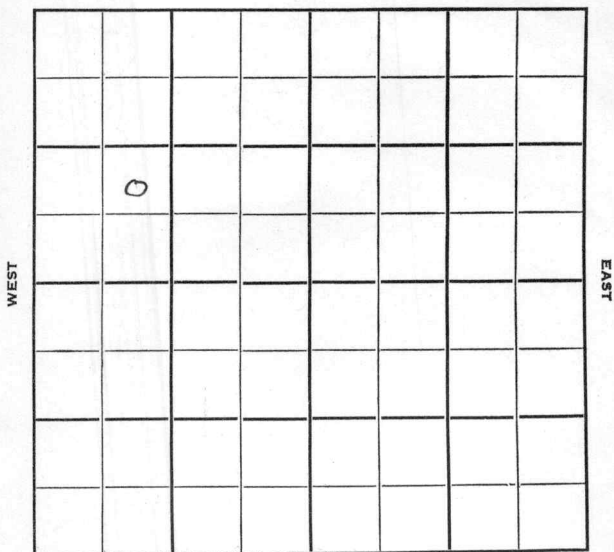

SOUTH

Butler KANSAS

Sec. 30 Twp. 26 R. 5 E

Well No. # 97 Koogler Farm

Magnolia Company

Contractor


 Ft. from N. Line

991 Ft. from S. Line

 Ft. from E. Line

990 Ft. from W. Line

NE SW NW

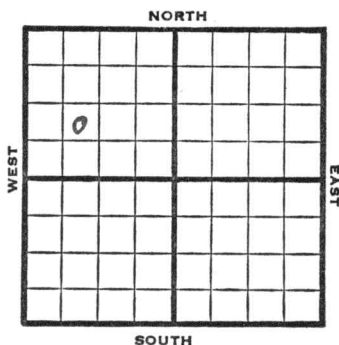

1952

Elev. 1344'

REPORT

5/21

Spud 5-15-52
8" @ 101
Drlg. 1947'

7/2

Spud 5-15-52
Oil well TD 2697' 8" @ 101
Miss 2505' Viola 2638' Simp. 2646'
TD 2697' 5" @ 2648' CO to 2697'
B/196 BWPD PB 2670' 38/2651-70
GO 4 GWPH 32/2637-45
1000 A 30 GO 60 GWPH
Comp. 2½ BOPD 65 BW


COMPLETED

County **Butler** State **Kansas**
 Sec. **30** (Blk.) **26** (Sur.) **5E** Map No.

Operator **Magnolia**

Well No. **97** Farm **Koogler**

Elev. Location **NE SW NW**

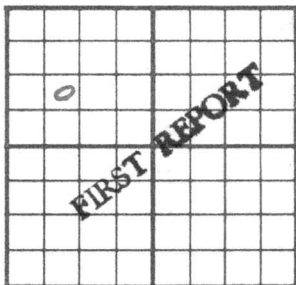

991 Ft. From **S** Line **NW**

990 Ft. From **W** Line Quarter

1st. Report **MAY 21 1952**

Completion


Remarks

Spudding Date **5-15-52**

Drlg. Data

8" @ 101 Drlg. 1947

J. G. McGEHEE

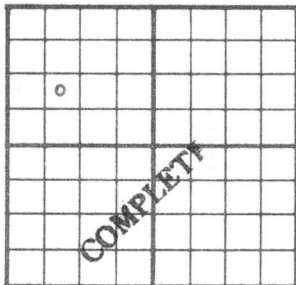County Butler State KansasSec. 30 (Blk.) 26 (Sur.) 5E Map No.Operator MagnoliaWell No. 97 Farm KooglerElev. 1344 Location NE SW NW991 Ft. From S Line NW990 Ft. From W Line Quarter1st. ReportCompletion 1952RemarksSpudding Date 5-15-52Drlg. Data Oil well TD 26978" @ 101 Miss. 2505 Viola 2638Simp. 2646 TD 2697 5" @ 2648CO to 2697 B/ 196 gwph PB 267038/ 2651-70 $\frac{1}{4}$ go 4 gwph 32/ 2637-451000 A 30 go 60 gwphComp. $2\frac{1}{2}$ bopd 65 bw