

Map No. _____ Sec. 35 Twp. 25 R. 10
Well No. 6 Graham (Graham) Farm
Rogers Ekal _____ Company

NORTH

WEST

EAST

SOUTH

Location _____

Drilling Remarks:

Rig up _____

Drilling Remarks:

RECORD

Cased _____ in. _____ ft.

Sand _____

Gas _____

Oil _____

Total Depth_____

PRODUCTION

1st 24 hrs Nat. _____

1st 24 hrs. after shot_____


Gas _____ cu. ft.

Dry Hole _____

Abandoned _____

Map No. _____ Sec. 35 Twp. 25 R. 10
Well No. 6 Graham Farm _____
Rogers Etal Company _____

_____ Ft. from N. Line
660 Ft. from S. Line
200 Ft. from E. Line
_____ Ft. from W. Line

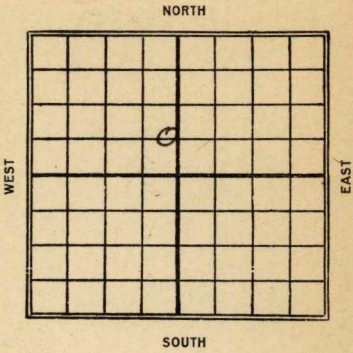

Date	REPORT
1923	
1/12	Dg. 1750'
3/2	Sand 1970-78- 10 Bbls.
	ID. 1978'

Map No. **KANSAS 16** Sec. **35** Twp. **25** R. **10**

Well No. **6** **Grapham**

Royers et al Company

Contractor

FIRST REPORT

SECTION PLAT

Ft. from N. Line

660 Ft. from S. Line

200 Ft. from E. Line

Ft. from W. Line

Location

Rig up

Drilling and Remarks:

dly 1750

RECORD

Cased _____ in., _____ ft.

Sand _____

Gas _____

Oil _____

Total Depth _____

PRODUCTION

1st 24 hrs. Nat. _____

1st 24 hrs. after shot _____

Gas _____ Cu. Ft.

Dry Hole _____

Abandoned _____

Date **JAN 12 1923**

191 **M. A. BENEAR** Scout

KANSAS

Map No. 1633 Sec. 25 Twp. 10 R. 10Well No. 6 GrahamRogers et al Company

Contractor

COMPLETED SECTION PLAT

Ft. from N. Line

660 Ft. from S. Line200 Ft. from E. Line

Ft. from W. Line

Location

Rig up

Drilling and Remarks:

RECORD

Cased _____ in., _____ ft.

Sand _____

Gas _____

Oil 1970-78Total Depth 1978

PRODUCTION

1st 24 hrs. Nat. 10

1st 24 hrs. after shot _____

Gas _____ Cu. Ft.

Dry Hole _____

Abandoned _____

Date

MAR 2 1921

M. A. BENEAR

Scout