


Section 17 Township 26 Range 6E

Well No. 2 Dean

Company J. E. Morris etal

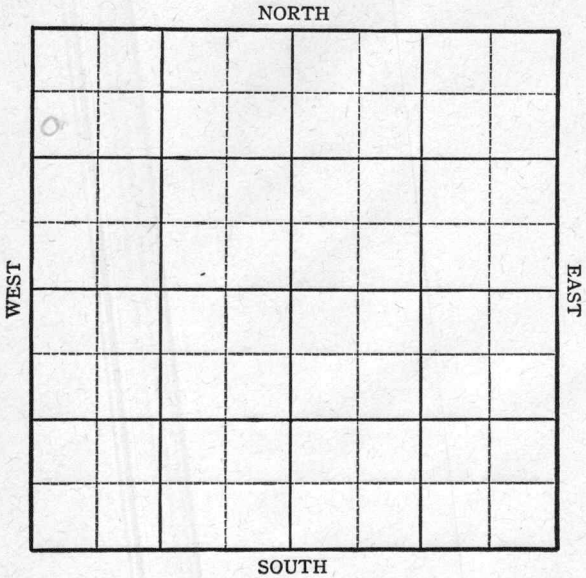

KANSAS

Butler

Sec. 17 Twp. 26 R. 6-E

Well No. #2 Dean Farm


J. E. Morris et al Company

_____ Ft. from N. Line

1410 Ft. from S. Line

_____ Ft. from E. Line

330 Ft. from W. Line

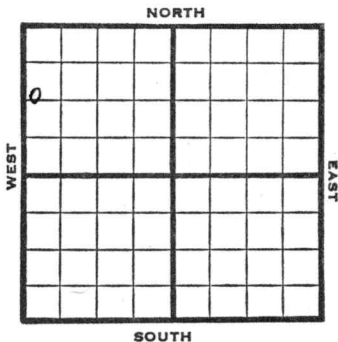

C W L W $\frac{1}{2}$ NW

Elev. 1378

REPORT

1945

- 9/12 Location
- 9/19 Machine
- 9/26 12" @ 785
Drlg. 790'
- 10/3 10" @ 1075
Drlg. 1525
- 10/10 Lens 1850
KC 2150
8" @ 2250
Drlg. 2315
- 10/17 Miss. 2790
TD 2840'

ABANDONED

KANSAS Pool Name Miscellaneous
Kansas

Map No. 14 Sec. 17 Twp. 26 R. 6E

Well No. 2 Dean

J. E. Morris etal. Company

FIRST REPORT

Contractor

C W L W $\frac{1}{2}$ NW

SECTION PLAT

 Ft. from N. Line

1410 Ft. from S. Line

 Ft. from E. Line

330 Ft. from W. Line

9			

Butler County

Location X

Rig up

Drilling and Remarks:

RECORD

Cased in., ft.

Sand

Gas

Oil

Total Depth

PRODUCTION

1st 24 hrs. Nat.

1st 24 hrs. after shot

Gas Cu. Ft.

Dry Hole

Abandoned

Date

SEP 12 1945

19

S. J. LEWIS

Scout

KANSAS

Kansas

Pool Name MiscellaneousMap No. 14 Sec. 17 Twp. 26 R. 6EWell No. 2 DeanJ. E. Morris etal Company

ABANDONED

Contractor

C W L $W\frac{1}{2}$ NWE 1, 1378

SECTION PLAT

 Ft. from N. Line1410 Ft. from S. Line Ft. from E. Line330 Ft. from W. Line

0			

Butler County

Location Rig up

Drilling and Remarks:

Miss 2798

RECORD

Cased in., ft.Sand Gas Oil Total Depth 2840

PRODUCTION

1st 24 hrs. Nat. 1st 24 hrs. after shot Gas Cu. Ft.Dry Hole Abandoned

Date

OCT 17 1945 19

S. J. LEWIS Scout