

Butler

KANSAS

Section 16 Township 26 Range 6EWell No. #1 DickinsonCompany J. E. Morris

NORTH

		0					

WEST

EAST

SOUTH

Butler

KANSAS

Sec. 16 Twp. 26 R. 6E

Well No. #1 Dickinson Farm

J. E. Morris Company

Wildcat Contractor


330' Ft. from N. Line

 Ft. from S. Line

990' Ft. from E. Line

 Ft. from W. Line

NW NE NW

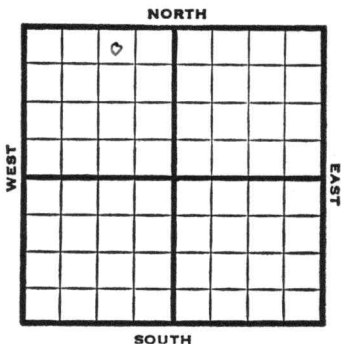

1950

Elev 1390' REPORT

12/13 RUR

1951

1/17

Spud 12-17-50

10" @ 1045

8" @ 2225

Lans 1822

Bart Sd 2665

7" @ 2695

Base Bart 2765

HFW 2760-65

5" @ 2802

Miss 2771

TD 2841

D&A

ABANDONED


County Butler State KansasSec. 16 (Blk. 26 (Sur. 6E Map No.)
(Twp.) (Rge.)Operator J. E. MorrisWell No. 1 Farm DickinsonElev. Location NW NE NW

		0							

FIRST REPORT

330 Ft. From N Line NW990 Ft. From E Line Quarter1st. Report DEC 13 1950Completion Remarks Cities Service DTMSpudding Date Drlg. Data WildcatRUR

J. E. TYRA

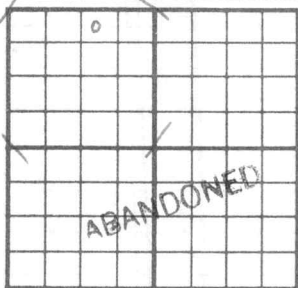County Butler State KansasSec. 16 (^{Blk.}_{Twp.}) 2 6 (^{Sur.}_{Rge.}) 6E Map No.Operator J. E. MorrisWell No. 1 Farm DickinsonElev. 1390 Location NW NE NW330 Ft. From N Line NW990 Ft. From E Line Quarter

1st. Report

Completion JAN 17 1951Remarks WildcatSpudding Date 12-17-50Drlg. Data D & A TD 284110" @ 1045 8" @ 2225 Lans. 1822Bart. sd. 2665 7" @ 2695 Base Bart. 2765HFW 2760-65 5" @ 2802 Miss. 2771TD 2841 D & A

J. E. TYRA