


Map No. Kansas Sec. 18 Twp. 25 R. 8 ✓
Well No. 1 Moffitt Bros. Farm
J. H. Liggett Company
NORTH

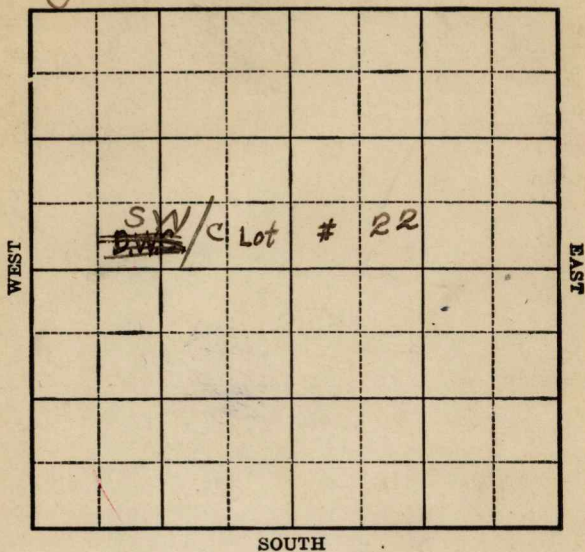

Location _____

Drilling Remarks: _____

Rig Up _____

Drilling Remarks: _____

RECORD

Cased _____ in. _____ ft.

Sand _____

Gas _____

Oil _____

Total Depth _____

PRODUCTION

1st 24 hrs. Nat. _____

1st 24 hrs. after shot _____

Gas _____ cu. ft.

Dry Hole _____

Abandoned _____


Map No. Kansas Sec. 18 Twp. 25 R. 8Well No. 1 Moffett Bros Farm
J. H. Liggett Company

Ft. from N. Line

Ft. from S. Line

Ft. from E. Line

Ft. from W. Line

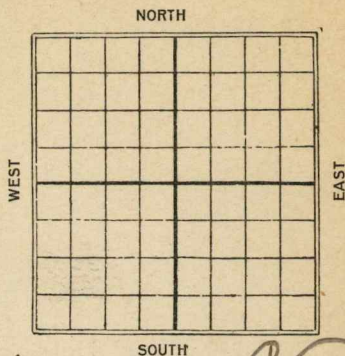C.
SW cor Lot #22

Date

REPORT

1925

5/1 Rye up

5/29 Dig 1425

6/5 2120

6/12 Running 5" 2400

6/19 2775

6/26 T.D. 2817 T.L. 2795 H.F.W.

2810 Dry and Alred.

Map No. 12 Chds Sec. 18 Twp. 25 R. 8Well No. 1 modified Bros

J. H. Liggett Company

Contractor

Southwest Corner
Lot #22.

SECTION PLAT

Dwc Lot #22.

Ft. from N. Line

Ft. from S. Line

Ft. from E. Line

Ft. from W. Line

FIRST REPORTS

Location ✓Rig up ✓

Drilling and Remarks:

RECORD

Cased _____ in., _____ ft.

Sand _____

Gas _____

Oil _____

Total Depth _____

PRODUCTION

1st 24 hrs. Nat. _____

1st 24 hrs. after shot _____

Gas _____ Cu. Ft.

Dry Hole _____

Abandoned _____

Date

MAY 1 1925

192

CHAS. L. SHERWOOD

Scout

Map No. 15 Shors Sec. 18 Twp. 25 R. 8Well No. J. H. Liggitt Bros Company _____

Contractor _____

SW¹/₄ Lot #22.

SECTION PLAT

COMPLETED

_____ Ft. from N. Line

_____ Ft. from S. Line

_____ Ft. from E. Line

_____ Ft. from W. Line

ABANDONED

Location _____

Rig up _____

Drilling and Remarks:

Top line 2795'
 HFW 2810'
 Dry & abandoned
 LD 2817'

RECORD

Cased _____ in., _____ ft.

Sand _____

Gas _____

Oil _____

Total Depth 2817'

PRODUCTION

1st 24 hrs. Nat. _____

1st 24 hrs. after shot _____

Gas _____ Cu. Ft.

Dry Hole ✓Abandoned ✓

Date

JUN 26 1925

CHAS. L. SHERWOOD

192

Scout