



Map No. X Sec. 21 Twp. 25 R. 8

Well No. 1 Robbins Farm  
Mittler-Henriksen Company


NORTH

\_\_\_\_\_ Ft. from N. Line

200 Ft. from S. Line

700 Ft. from E. Line

\_\_\_\_\_ Ft. from W. Line

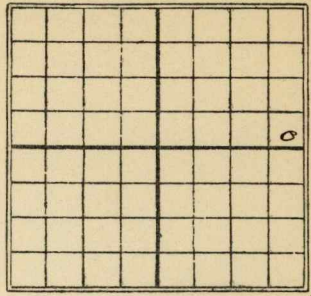

SOUTH

Date  
1922

REPORT

<u>1/27</u>	<u>ally 300'</u>
<u>2/4</u>	<u>500</u>
<u>3/30</u>	<u>2100'</u>
<u>4/9</u>	<u>D &amp; A 2580'</u>

Map No. K15 Sec. 21 Twp. 25 R. 8

Well No. 1 Robbins

Miller & Henderson Company

Contractor

**FIRST REPORT**

**SECTION PLAT**

----- Ft. from N. Line

200' Ft. from S. Line

200' Ft. from E. Line

----- Ft. from W. Line

			0

Location -----

Rig up -----

Drilling and Remarks:

200y 300

**RECORD**

Cased ----- in., ----- ft.

Sand -----

Gas -----

Oil -----

Total Depth -----

**PRODUCTION**

1st 24 hrs. Nat. -----

1st 24 hrs. after shot -----

Gas ----- Cu. Ft.

Dry Hole -----

Abandoned -----

Date

JAN 27 1922 191

M. A. BENEAR Scout

Map No. 15 Sec. 21 Twp. 25 R. 8

Well No. 1 Robbins  
Miller & Henderson Company

Contractor

COMPLETED

SECTION PLAT


ABANDONED

\_\_\_\_\_ Ft. from N. Line

200 Ft. from S. Line

200 Ft. from E. Line

\_\_\_\_\_ Ft. from W. Line

Location \_\_\_\_\_

Rig up \_\_\_\_\_

Drilling and Remarks:

10 x 9,  
25 80'

RECORD

Cased \_\_\_\_\_ in., \_\_\_\_\_ ft

Sand \_\_\_\_\_

Gas \_\_\_\_\_

Oil \_\_\_\_\_

Total Depth \_\_\_\_\_

PRODUCTION

1st 24 hrs. Nat. \_\_\_\_\_

1st 24 hrs. after shot \_\_\_\_\_

Gas \_\_\_\_\_ Cu. Ft

Dry Hole \_\_\_\_\_

Abandoned \_\_\_\_\_

Date

APR 19 1922 191 \_\_\_\_\_

**M. A. BENEAR**

Scour