


Map No. 15 Sec. 21 Twp. 25 R. 8E
 Well No. 1- Robbins Farm
C.C. Sheldon et al Company

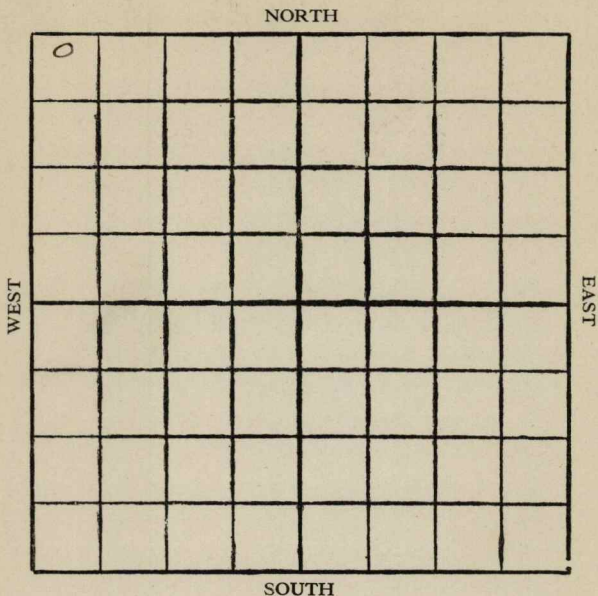

Location

Drilling Remarks

.....

.....

RECORD

Cased in. ft.

Sand

Gas

Oil

Total Depth

Rig Up

Drilling Remarks

.....

.....

PRODUCTION

1st 24 hrs. Nat.

1st 24 hrs. after shot

Gas cu. ft.

Dry Hole

Abandoned

Butler


Map No. 15 Sec. 21 Twp. 25 R 8 E
 Well No. 1 - Robbins Farm
C. C. Sheldon et al Company

NORTH

180 Ft. from N. Line

Ft. from S. Line

Ft. from E. Line

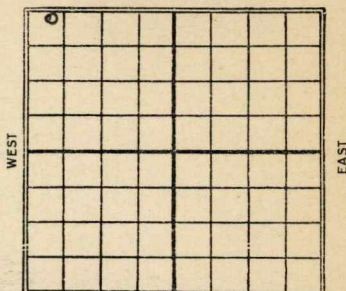360 Ft. from W. Line

SOUTH

1926

Date

REPORT

12/2 Ro G.12/8 rig12/15 —12/22 Rigging up12/30 Spudding19271/6 Drlg 9501/13 " 14351/19 fishing Casing 15851/26 underreaming 19352/3 Drilling 26902/10 Top line 2705D. & A. 2733 - HFW.

Butler ✓
 15 KANSAS 21 25 8
 Map No. _____ Sec. _____ Twp. _____ R. _____
 Well No. 1 Bigkins
 C. C. Sheldon et al Company
 _____ Contractor

FIRST REPORTS

SECTION PLAT

180 _____ Ft. from N. Line
 _____ Ft. from S. Line
 _____ Ft. from E. Line
 360 _____ Ft. from W. Line

0			

Location _____
 Rig up _____
 Drilling and Remarks:

Bo 4

RECORD

Cased _____ in., _____ ft.
 Sand _____
 Gas _____
 Oil _____
 Total Depth _____

PRODUCTION

1st 24 hrs. Nat. _____
 1st 24 hrs. after shot _____
 Gas _____ Cu. Ft.
 Dry Hole _____
 Abandoned _____

Date DEC 2 1926 CHAS. L. SHERWOOD
 _____ 192 _____ Scout

15 **KANSAS** Sec. 21 Twp. 25 R. 8

Well No. 1 *Robinson*
C. C. Shelton et al Company

Contractor

COMPLETED**SECTION PLAT**

180 Ft. from N. Line

Ft. from S. Line

Ft. from E. Line

360 Ft. from W. Line

ABANDONED

0			

Location

Rig up

Drilling and Remarks:

Top line 2705

DDH 2733
AFW

RECORD

Cased _____ in., _____ ft.

Sand _____

Gas _____

Oil _____

Total Depth *2733***PRODUCTION**

1st 24 hrs. Nat. _____

1st 24 hrs. after shot _____

Gas _____ Cu. Ft.

Dry Hole ☒Abandoned ☒

Date

FEB 10 1927 **CHAS. L. SHERWOOD** Scout