


Map No. _____ Sec. 22 Twp. 25 R. 8

Well No. 2 Roffinal Farm _____
Parker et al Company _____

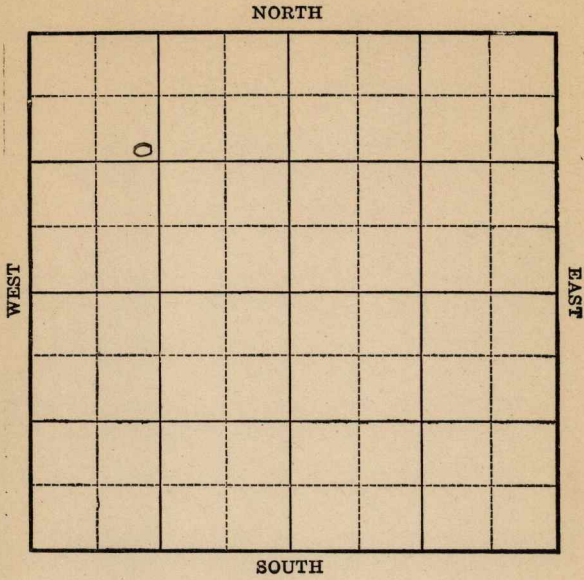

Location _____

Drilling Remarks:

Rig up _____

Drilling Remarks:

RECORD

Cased _____ in. _____ ft.

Sand _____

Gas _____

Oil _____

Total Depth _____

PRODUCTION

1st 24 hrs Nat. _____

1st 24 hrs. after shot _____

Gas _____ cu. ft.

Dry Hole _____

Abandoned _____

Map No. **KANSAS** ¹⁵ Sec. **22** Twp. **25** R. **8**

Well No. **2 Rappers**
Parker et al Company

Contractor

FIRST REPORT SECTION PLAT

1120 Ft. from N. Line
----- Ft. from S. Line
----- Ft. from E. Line
1120 Ft. from W. Line

0			

Location -----
 Rig up **✓✓** -----
 Drilling and Remarks:

RECORD

Cased ----- in., ----- ft.
 Sand -----
 Gas -----
 Oil -----
 Total Depth -----

PRODUCTION

1st 24 hrs. Nat. -----
 1st 24 hrs. after shot -----
 Gas ----- Cu. Ft.
 Dry Hole -----
 Abandoned -----

Date **MAR 30 1923** **M. A. BENEAR**
 ----- **192** ----- Scout

Map No. ¹⁵ *Kanel* Sec. *22* Twp. *25* R. *8*

Well No. *2 Rabbits*
Parker et al Company

Contractor
Abandoned

SECTION PLAT

1120 Ft. from N. Line

----- Ft. from S. Line

----- Ft. from E. Line

1120 Ft. from W. Line

<i>0</i>			

Location -----

Rig up -----

Drilling and Remarks:

LO + D
2570'

RECORD

Cased ----- in., ----- ft.

Sand -----

Gas -----

Oil -----

Total Depth -----

PRODUCTION

1st 24 hrs. Nat. -----

1st 24 hrs. after shot -----

Gas ----- Cu. Ft.

Dry Hole -----

Abandoned -----

Date

8/4 192 *3 MMB* Scout