


DX 78-1

Section 24 Township 25 Range 8EWell No. 2 HoffmanCompany J. H. Wagner

NORTH

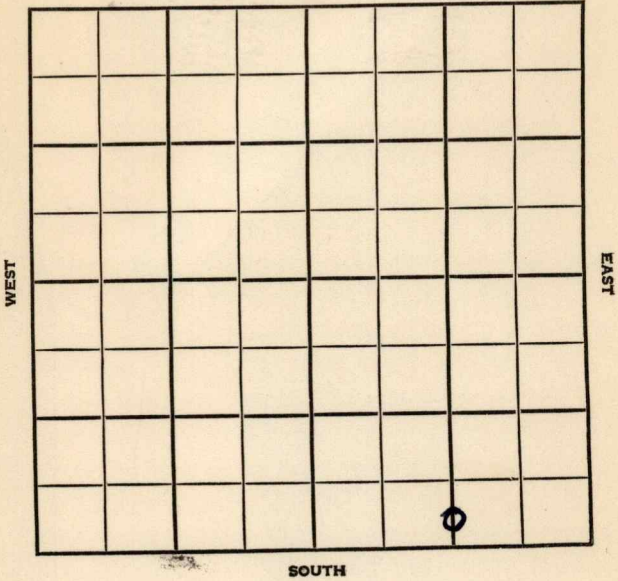

SEC.	24	TWP.	25	R.	8E
------	----	------	----	----	----

WELL NO.

2 Hoffman

FARM

COMPANY

J. H. Wagner

CONTRACTOR

Co. tools

Sallyards Pool

_____ Ft. from N. Line


200

_____ Ft. from S. Line

1320

_____ Ft. from E. Line

_____ Ft. from W. Line

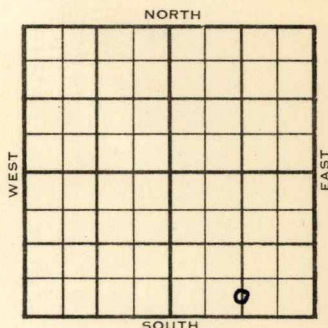C S $\frac{1}{2}$ S $\frac{1}{2}$ SE

1954

ELEVATION

REPORT

7/28

Spd^g 7-10-54

12" @90

fsg @ 1095

8/25

Spud 7-10-54 Oil well TD 2387

12" @ 90 Lans. 1500 8" @ 1508

B. Lans. 1540 Cattleman sd 2268


TD 2387 5" @ 2369 CO to 2387

S/7 $\frac{1}{2}$ BOPD frac.

Comp. 25 BOPD

COMPLETED

County **Greenwood** State **Kansas**
 Sec. **24** (Blk.) **25** (Sur.) **8E** Map No.
 (Twp.)
 Operator **J. H. Wagner**
 Well No. **2** Farm **Hoffman**
 Elev. Location **C S $\frac{1}{2}$ S $\frac{1}{2}$ SE**

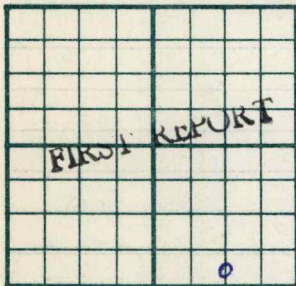

200 Ft. From **S** Line **SE**
1320 Ft. From **E** Line Quarter

1st. Report **JUL 28 1954**

Completion


Remarks

Co. tools

Spudding Date **7-10-54**

Drlg. Data **Sallyards Pool**

12" @ 90 fsg. @ 1095

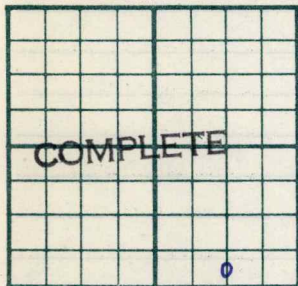County Greenwood State KansasSec. 24 (Blk.
Twp.) 25 (Sur.
Rge.) 8E Map No.Operator J. H. WagnerWell No. 2 Farm HoffmanElev. Location C S $\frac{1}{2}$ S $\frac{1}{2}$ SE200 Ft. From S Line SE1320 Ft. From E Line Quarter1st. ReportCompletion AUG 25 1954Remarks Sallyards PoolCo. toolsSpudding Date 7-10-54Drilg. Data Oilwell TD 238712" @ 90 Lans. 1500 8" @ 1508B. Lans. 1540 Cattleman sd. 2268TD 2387 5" @ 2369 CO to 2387 S/ 7 $\frac{1}{2}$ bop'dfrac Comp. 25 bop'd

FABEN GILSTRAP