


Section 13 Township 26 Range 6-E

Well No. #1 Webb

Company Dilworth Hager

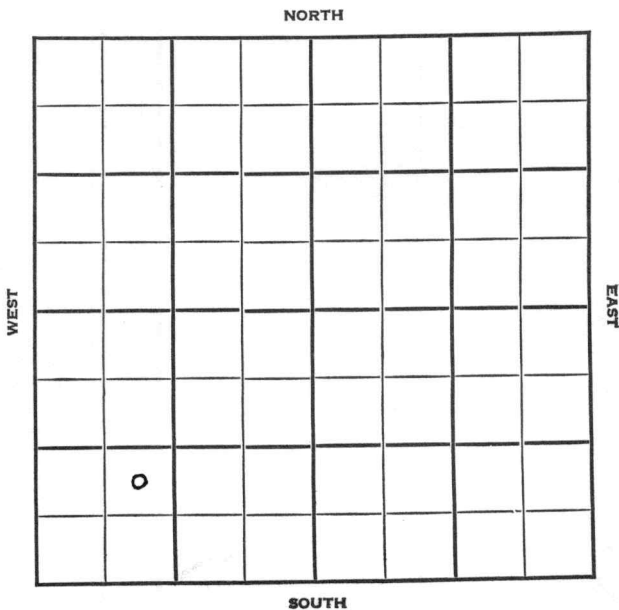



Sec. 13 Twp. 26 R. 6-E

Well No. #1 Webb Farm
Dilworth Hager Company


Miscellaneous

 Ft. from N. Line

990' Ft. from S. Line

 Ft. from E. Line

990' Ft. from W. Line

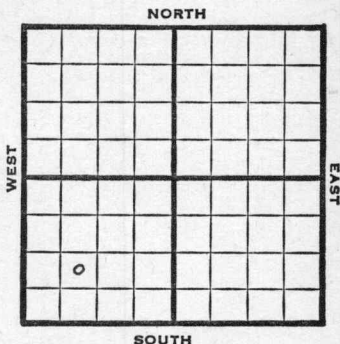

NE SW SW

1948

REPORT

1/7

Mississippi 2740'

TD 2745'

D&A

FIRST REPORT

X
ABANDONED

