

Map No. _____ Sec. 23 Twp. 25 R. 8

Well No. 2 Jackson Farm

Mid Kansas Oil Company

NORTH

WEST

EAST

SOUTH

Location -----

Drilling Remarks:

Rig Up -----

Drilling Remarks:

RECORD

Cased----- in.----- ft.

Sand -----

Gas -----

Oil_____

Total Depth -----

PRODUCTION

1st 24 hrs. Nat.-----

1st 24 hrs. after shot_____

Gas ----- cu. ft.

Dry Hole -----

Abandoned -----

Map No. K15 Sec. 23 Twp. 25 R. 8
Well No. 2 Jackson
Mid-Kansas Oil Company
Contractor

NORTH							
WEST							
SOUTH							
EAST							

200-S 1100-W

Location _____
Rig up ☒
Drilling and Remarks:

RECORD

Cased _____ in., _____ ft.
Sand _____
Gas _____
Oil _____
Total Depth _____

PRODUCTION

1st 24 hrs. Nat. _____
1st 24 hrs. after shot _____
Gas _____ Cu. Ft.
Dry Hole _____
Abandoned _____


Date 11/27 1918 Cyber Scout

Map No. K15 Sec. 23 Twp. 25 R. 8Well No. 2 Jackson
Mid-Kansas Oil Company

Contractor _____

NORTH

WEST

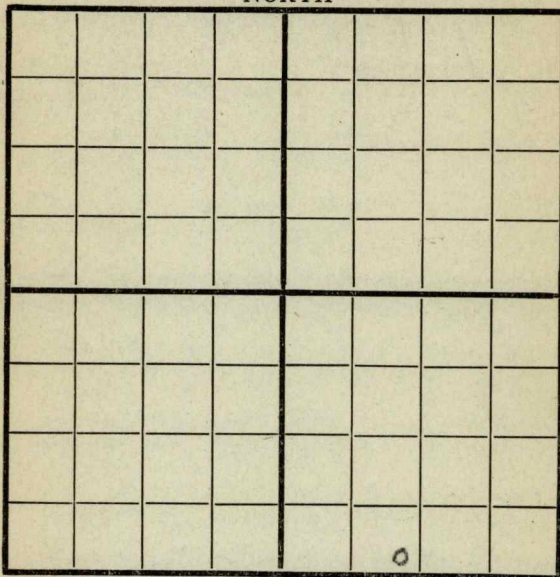

EAST

SOUTH

200-S1100-VV

Location _____

Rig up _____

Drilling and Remarks:

Spudding

RECORD

Cased _____ in., _____ ft.

Sand _____

Gas _____

Oil _____

Total Depth _____

PRODUCTION

1st 24 hrs. Nat. _____

1st 24 hrs. after shot _____

Gas _____ Cu. Ft.

Dry Hole _____

Abandoned _____

Date

12/2 1918Cyle Scout

Map No. K 15 Sec. 23 Twp. 25 R. 8
 Well No. 2 Jackson
Mid-Kansas Oil Company
 Contractor _____

NORTH							
WEST							
SOUTH							
<u>200-S</u>				<u>1100-W</u>			

Location _____
 Rig up _____
 Drilling and Remarks:

520'
in 12 1/2" hole

RECORD

Cased _____ in., _____ ft.
 Sand _____
 Gas _____
 Oil _____
 Total Depth _____

PRODUCTION

1st 24 hrs. Nat. _____
 1st 24 hrs. after shot _____
 Gas _____ Cu. Ft.
 Dry Hole _____
 Abandoned _____

Date

12/9 1918

H. B.


Scout

Map No. K 15 Sec. 23 Twp. 25 R. 8
 Well No. 2 Jackson
Mid-Kansas Oil Company
 Contractor

NORTH

WEST

EAST

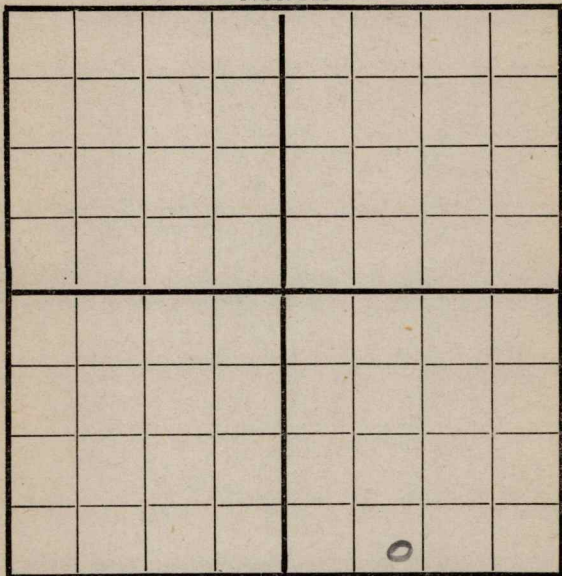

SOUTH

200-S

1100-W

Location _____

Rig up _____

Drilling and Remarks:

1000'

RECORD

Cased _____ in., _____ ft.

Sand _____

Gas _____

Oil _____

Total Depth _____

PRODUCTION

1st 24 hrs. Nat. _____

1st 24 hrs. after shot _____

Gas _____ Cu. Ft.

Dry Hole _____

Abandoned _____

Date

12/19 1918 Pyle

Sc


Map No. K15 Sec. 23 Twp. 25 R. 8Well No. 2 Jackson
Mid. Kansas Company _____

Contractor _____

NORTH

WEST

EAST

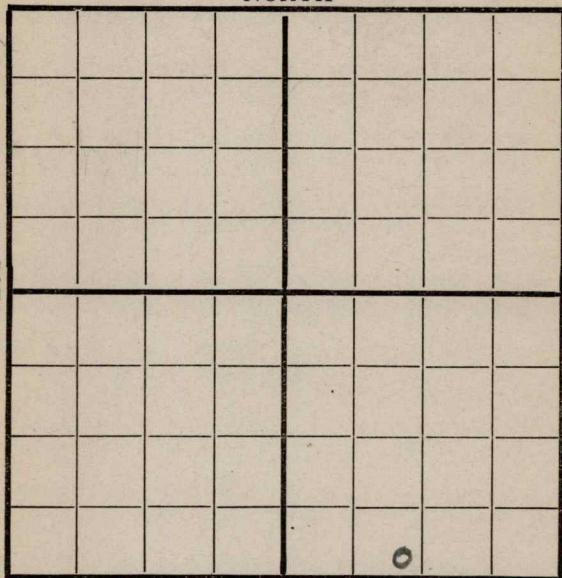

200 S

SOUTH

1100-W

Location _____

Rig up _____

Drilling and Remarks:

D. D. C.

1000'

RECORD

Cased _____ in., _____ ft.

Sand _____

Gas _____

Oil _____

Total Depth _____

PRODUCTION

1st 24 hrs. Nat. _____

1st 24 hrs. after shot _____

Gas _____ Cu. Ft.

Dry Hole _____

Abandoned _____

Date

12/23

1918

Pyle

Score _____


Map No. K15 Sec. 23 Twp. 25 R. 8Well No. 2 JacksonMid. Kansas Company

Contractor

NORTH

WEST

EAST

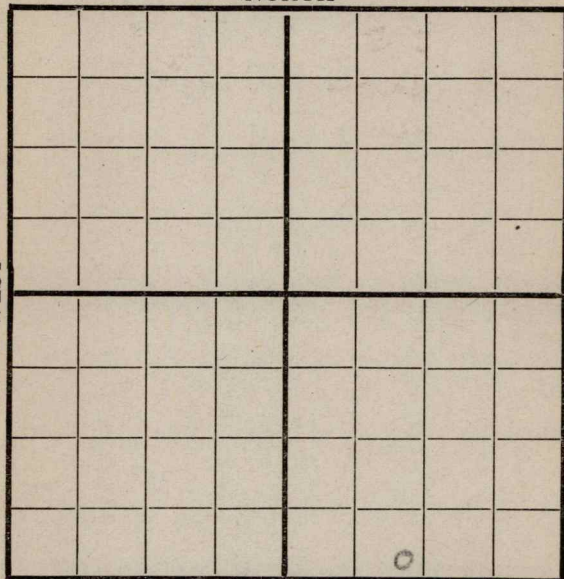

SOUTH

200 S

1100-W

Location _____

Rig up _____

Drilling and Remarks:

21 R. 10"
to 1400'

RECORD

Cased _____ in., _____ ft.

Sand _____

Gas _____

Oil _____

Total Depth _____

PRODUCTION

1st 24 hrs. Nat. _____

1st 24 hrs. after shot _____

Gas _____ Cu.

Dry Hole _____

Abandoned _____

Date

Jan 17 1918

Pyle


Map No. K15 Sec. 23 Twp. 25 R. 8Well No. 2 JacksonMid. Kansas Oil Company

Contractor _____

NORTH

WEST

EAST

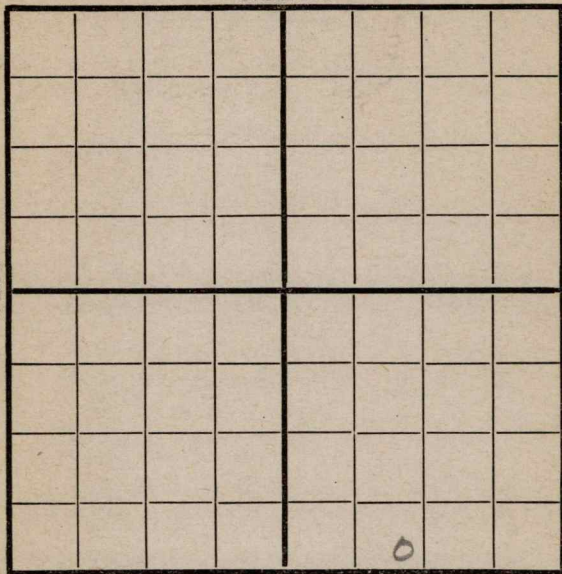

SOUTH

20051100 W

Location _____

Rig up _____

Drilling and Remarks:

1500'

RECORD

Cased _____ in., _____ ft.

Sand _____

Gas _____

Oil _____

Total Depth _____

PRODUCTION

1st 24 hrs. Nat. _____

1st 24 hrs. after shot _____

Gas _____ Cu. Ft.

Dry Hole _____

Abandoned _____

Date

Jan 23 1919

Pyle

Scout


Map No. K15 Sec. 23 Twp. 25 R. 8Well No. 2 JacksonM. W. Kansas Oil Company

Contractor

NORTH

WEST

EAST

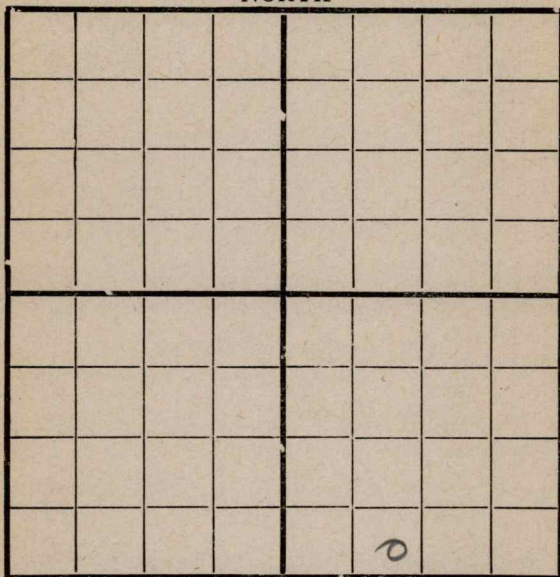

2005

SOUTH

1100 W

Location

Rig up

Drilling and Remarks:

D. R. 10"
1400 to 1500'

RECORD

Cased _____ in., _____ ft.

Sand _____

Gas _____

Oil _____

Total Depth _____

PRODUCTION

1st 24 hrs. Nat. _____

1st 24 hrs. after shot _____

Gas _____ Cu. Ft.

Dry Hole _____

Abandoned _____

Date


Pyle

191

Scout

Map No. K15 Sec. 23 Twp. 25 R. 8
 Well No. 2 Jackson
Mid. Kansas Oil Company
 Contractor _____

NORTH

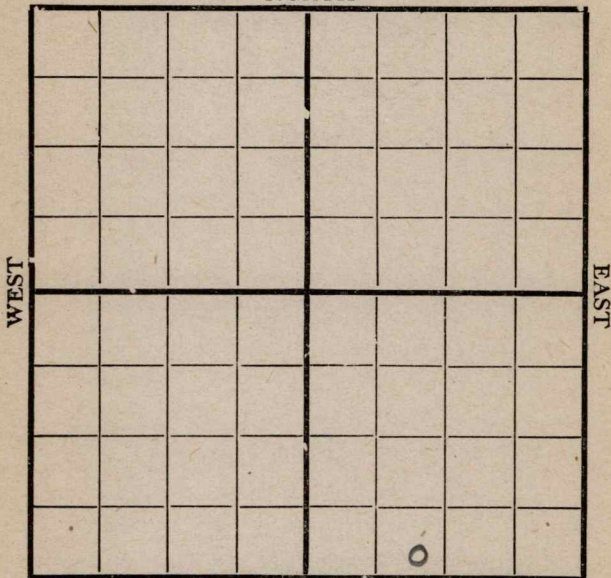

200 S

SOUTH

1100 W

Location _____
 Rig up _____
 Drilling and Remarks:

RECORD

Cased _____ in., _____ ft.
 Sand _____
 Gas _____
 Oil _____
 Total Depth _____

PRODUCTION

1st 24 hrs. Nat. _____
 1st 24 hrs. after shot _____
 Gas _____ Cu. Ft.
 Dry Hole _____
 Abandoned _____

Date

2/4 1919

Pyle


Scout

Map No. K15 Sec. 23 Twp. 25 R. 8
 Well No. 2 Jackson
Mid. Kansas Oil Company
 Contractor

NORTH

WEST

EAST

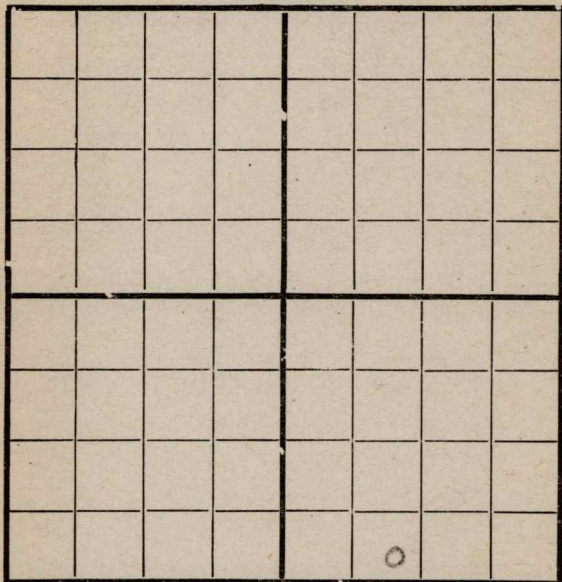

200 S

SOUTH

1100 W

Location _____

Rig up _____

Drilling and Remarks:

RECORD

Cased _____ in., _____ ft.

Sand _____

Gas _____

Oil _____

Total Depth _____

PRODUCTION

1st 24 hrs. Nat. _____

1st 24 hrs. after shot _____

Gas _____ Cu. Ft.

Dry Hole _____

Abandoned _____

Date

1919

Scout

Shally Sand
 2494
 2502
 No oil

Cyle

Map No. K15 Sec. 23 Twp. 25^s R. 8E
Well No. 2 Jackson
Mid-Kansas Oil Company
Contractor

NORTH							
WEST							
SOUTH							
EAST							

2005

SOUTH

1100 W

Location _____

Rig up _____

Drilling and Remarks:

Shaly Sand
2494-2502
no oil

RECORD

Cased _____ in., _____ ft.

Sand _____

Gas _____

Oil _____

Total Depth _____

PRODUCTION

1st 24 hrs. Nat. _____

1st 24 hrs. after shot _____

Gas _____ Cu. Ft.

Dry Hole _____

Abandoned _____


Date

2/21 1919

Pyle

Scout

Map No. K15 Sec. 23 Twp. 25 R. 8
Well No. 2 Jackson
Mid-Kansas Oil Company
Contractor

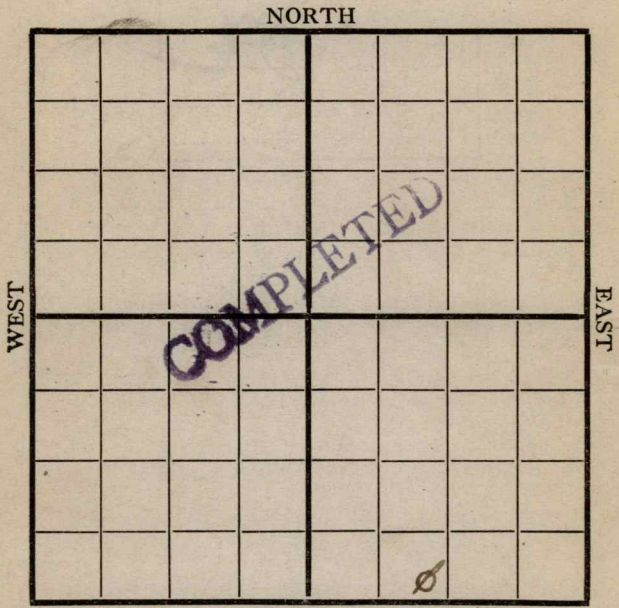

SOUTH
500' S - 1100' W

Location _____
Rig up _____
Drilling and Remarks:

RECORD

Cased _____ in., _____ ft.
Sand _____
Gas _____
Oil _____
Total Depth _____

PRODUCTION

1st 24 hrs. Nat. _____
1st 24 hrs. after shot _____
Gas _____ Cu. Ft.
Dry Hole 2576
Abandoned _____

Date

2/26 1919 Gyle Scout