

Map No. Kan Sec. 21 Twp. 26 R. 6


Well No. 1 McMechan Farm
J K Wilson et al Company

200 Ft. from N. Line

..... Ft. from S. Line

1120 Ft. from E. Line

..... Ft. from W. Line

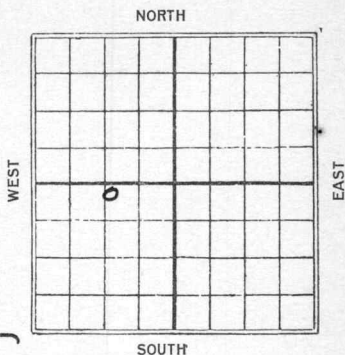

Date	REPORT
1925	
7/10	Location
7/17	_____
7/24	_____
7/21	Rigging up
8/7	_____
8/14	850'
8/20	10" 1150 - D 1250
8/27	1800'
9/3	2210'
9/11	2570'
9/19	Abandoned 2804

Map No. 14 Smds Sec. 21 Twp. 26 R. 6

Well No. 1 Mc MECHAN

G. H. WILSON & H Company

Contractor

FIRST REPORTS

SECTION PLAT

200 Ft. from N. Line

_____ Ft. from S. Line

1120 Ft. from E. Line

_____ Ft. from W. Line

	0		

Location _____
Rig up _____
Drilling and Remarks:

RECORD

Cased _____ in., _____ ft.
Sand _____
Gas _____
Oil _____
Total Depth _____

PRODUCTION

1st 24 hrs. Nat. _____
1st 24 hrs. after shot _____
Gas _____ Cu. Ft.
Dry Hole _____
Abandoned _____

Date

JUL 10 1925
192

CHAS. L. SHERWOOD
Scout

Button Co

Map No. 14 KANSAS Sec. 21 Twp. 26 R. 6

Well No. 1 McMechen

J. S. Hildon et al Company

Contractor

COMPLETED

SECTION PLAT

200 Ft. from N. Line

_____ Ft. from S. Line

1120 Ft. from E. Line

_____ Ft. from W. Line

ABANDONED

	o		

Location _____

Rig up _____

Drilling and Remarks:

Top hole 2765'
Dry & whd
L.O. 2804'

RECORD

Cased _____ in., _____ ft.

Sand _____

Gas _____

Oil _____

Total Depth 2804'

PRODUCTION

1st 24 hrs. Nat. _____

1st 24 hrs. after shot _____

Gas _____ Cu. Ft.

Dry Hole

Abandoned

Date

SEP 19 1925

CHAS. L. SHERWOOD