


Butler

Form 51-5M-5-34-Palace

Map No. KANSAS Sec. 30 Twp. 26 R. 6E

Well No. #1 Angus Farm
Roth O. Faust. Company

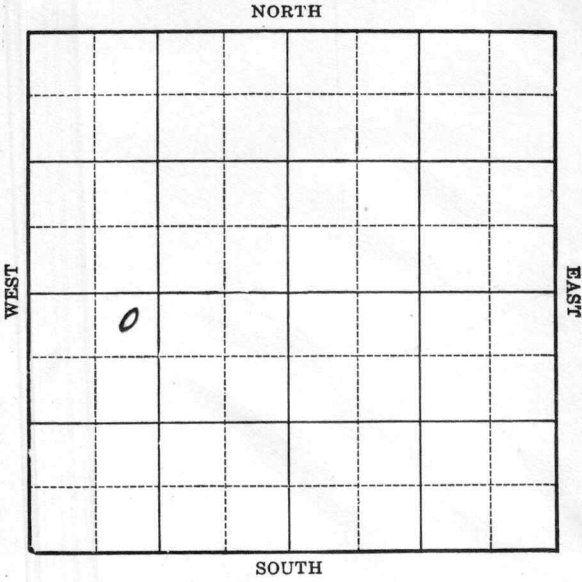

Location _____

Drilling Remarks _____

Rig Up _____

Drilling Remarks _____

RECORD

Cased _____ in. _____ ft.

Sand _____

Gas _____

Oil _____

Total Depth _____

PRODUCTION

1st 24 hrs. Nat. _____

1st 24 hrs. after shot _____

Gas _____ cu. ft.

Dry Hole _____


Abandoned _____

Butler

Map No. KANSAS Sec. 30 Twp. 26 R. 6E

Well No. #1 Unger Farm
Roth & Faurot Company

330 Ft. from N. Line
____ Ft. from S. Line
____ Ft. from E. Line
990 Ft. from W. Line

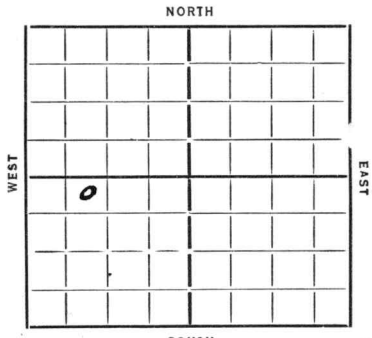

APPARENTLY A TWIN TO DRY HOLE - DO NOT HAVE

REPORT RECORD OF SAME

Date	Location	REPORT	RECORD OF SAME
1935			
2/6	Location		
2/14	—		
2/21	Ponds		
2/28	—		
3/7	Rgn		
3/14	—		
3/21	dy 450		
3/28	" 800	15" 344	
4/4	" 1525	17" 1066	
4/11	" 2018	10" 1697	
	8" 1995		
4/18	dy 7400	6" 2382	
4/26	H # W 2560 T 7 2600 WR 6"		
5/2	—		
5/9	6" 2600 5" 2740 50 2760		
	dy 3002		
5/15	Wilcox 3161 T 7 3165		
	170 FT.		

ABANDONED

Map No. 14 Sec. 30 Twp. 26 R. 63

Well No. 1- Ungew

Roth + Trauot Company

Contractor

FIRST REPORTS

SECTION PLAT

330 Ft. from N. Line

..... Ft. from S. Line

..... Ft. from E. Line

990 Ft. from W. Line

0			

Location

Rig up.....

Drilling and Remarks:

apparently a twin to dry hole. However, do not have record of same.

RECORD

Cased.....in.,ft.

Sand.....

Gas.....

Oil.....

Total Depth.....

PRODUCTION

1st 24 hrs. Nat.....

1st 24 hrs. after shot.....

Gas.....Cu. Ft.

Dry Hole.....

Abandoned.....

Date

2-6-34 192.....

ORVAL MANNSCHRECK

Scout

KANSAS

Form 26-1M Blks. 9-28

Map No. 14 Sec. 30 Twp. 26 R. 6 E

Well No. 1-Upper

Koth & Traut Company

Contractor

ABANDONED

SECTION PLAT

330 Ft. from N. Line
..... Ft. from S. Line
..... Ft. from E. Line
990 Ft. from W. Line

0			

Location.....

Rig up.....

Drilling and Remarks:

6 + 17

RECORD

Cased..... in., ft.

Sand Walcot 3161

Gas.....

Oil.....

Total Depth 3165

PRODUCTION

1st 24 hrs. Nat.....

1st 24 hrs. after shot.....

Gas..... Cu. Ft.

Dry Hole.....

Abandoned.....

Date

5-15-33 192..... Scout

ORVAL MANNSCHRECK