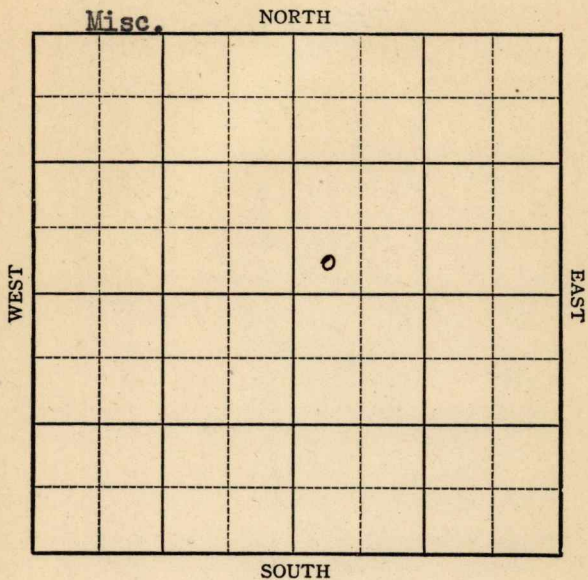


KANSAS

Section 24 Township 25 Range 8EWell No: 1 Hoffman "B"Company Ward McGinnis

KANSAS

Greenwood

V

24

25

8E

Sec. _____ Twp. _____ R. _____

Well No. 1 Hoffman "B" Farm _____

Ward McGinnis

Company _____


Miscellaneous

_____ Ft. from N. Line

330 Ft. from S. Line

_____ Ft. from E. Line

330 Ft. from W. Line

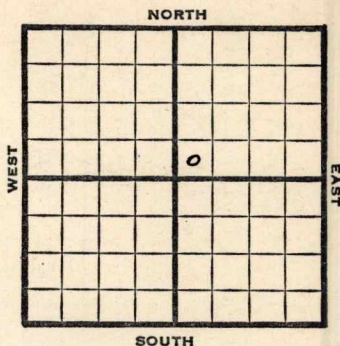

SW NE

REPORT

1947

5/7	Machine
5/13	Drlg 150'
5/20	Drlg 970'
5/27	970' SG
6/3	970SD
6/10	"
6/17	"
6/24	"
7/1	"
7/8	"
7/16	"
7/22	"
7/29	"
8/6	"
8/13	"
8/20	"

OVER

1947

8/27 900' SD

9/3 "

9/10 "

9/17 "

9/24 "

10/1 "

10/8 "

10/15 "

10/22 "

10/29 RUR

11/5 "

11/12 "

11/19 "

11/25 Bart. 2455-73'

TD 2473'

4" @ 2448'

RUST

12/3 30 qts. CO

12/10 Bart 2455'

Total Depth 2473'

ABANDONED

Map No. K15 Sec. 24 Twp. 25 R. 8E

Well No. 1 Hoffman "B"

Ward McGinnis Company

FIRST REPORT Contractor

SWNE


SECTION PLAT

 Ft. from N. Line

330 Ft. from S. Line

 Ft. from E. Line

330 Ft. from W. Line

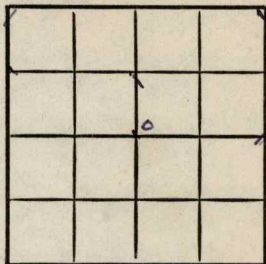

Greenwood County

Location

Rig up

Drilling and Remarks:

Machine

RECORD

Cased in., ft.

Sand

Gas

Oil

Total Depth

PRODUCTION

1st 24 hrs. Nat.

1st 24 hrs. after shot

Gas Cu. Ft.

Dry Hole

Abandoned

Date

MAY 7 1947 19 S. J. LEWIS Scout

Map No. 15 Sec. 24 Twp. 25 R. 8E

Well No. 1 Hoffman "B"

Ward McGinnis Company

ABANDONED

Contractor

SW NE

SECTION PLAT

		D	

 Ft. from N. Line

330 Ft. from S. Line

 Ft. from E. Line

330 Ft. from W. Line

Greenwood County

Location

Rig up

Drilling and Remarks:

Box 82455

RECORD

Cased in., ft.

Sand

Gas

Oil

Total Depth 2428

PRODUCTION

1st 24 hrs. Nat.

1st 24 hrs. after shot

Gas Cu. Ft.

Dry Hole

Abandoned

Date

DEC 10 1947

19

S. J. LEWIS

Scout