

See Dup

FORM 51 5M 6-46 PETROL


KANSAS

Greenwood county

Section 25 Township 25 Range 8-E

Well No. #1, Jackson

Company Nichols etal

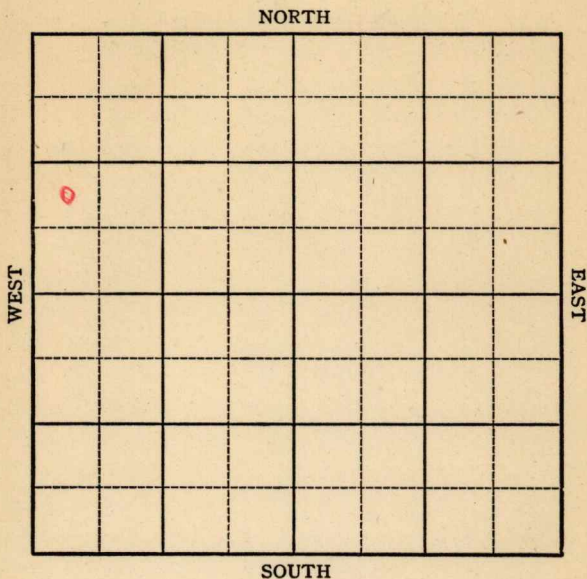

KANSAS

Greenwood ✓

Sec. 25 Twp. 25 R. 8E

Well No. #1 Jackson Farm

Nichols et al Company


Miscellaneous

Ft. from N. Line

990 Ft. from S. Line

Ft. from E. Line

330 Ft. from W. Line

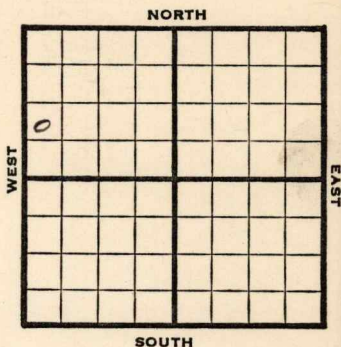

NW SW NW

1946

REPORT

11/6

8" @ 110'

Drlg 1490'

11/12

"

11/20

Bart 2346'

5" @ 2336'

TD 2360'

20 qts

Pump 20 POT

39 Grav.

COMPLETED

Kansas

Map No. 15 Sec. 25 Twp. 25 R. 8EWell No. 1 JacksonNichols etal. Company

FIRST REPORT Contractor

NW SW NW

SECTION PLAT

0			

 Ft. from N. Line990 Ft. from S. Line Ft. from E. Line330 Ft. from W. LineGreenwood CountyLocation Rig up

Drilling and Remarks:

8" @ 110

drlg. 1490

RECORD

Cased in., ft.Sand Gas Oil Total Depth

PRODUCTION

1st 24 hrs. Nat. 1st 24 hrs. after shot Gas Cu. Ft.Dry Hole Abandoned

Date

NOV 6 1946 19 S. J. LEWIS Scout

Map No. 15 Sec. 25 Twp. 25 R. 8E
 Kansas

Well No. 1 Jackson

Nichols et al. Company

COMPLETED

Contractor

NW SW NW

SECTION PLAT

0			

 Ft. from N. Line

990 Ft. from S. Line

 Ft. from E. Line

330 Ft. from W. Line

Greenwood County

Location

Rig up

Drilling and Remarks:

Bar Y 2846

5" C 2336

209 to

Pump 20 88

89 2 42

RECORD

Cased in., ft.

Sand

Gas

Oil

Total Depth 2960

PRODUCTION

1st 24 hrs. Nat.

1st 24 hrs. after shot

Gas Cu. Ft.

Dry Hole

Abandoned

Date

NOV 20 1946 19

S. J. LEWIS

Scout