
FORM 51 Dup Greenwood KANSAS

Section 25 Township 25 Range 8E

Well No. 1 Jackson

Company Bedell & Catt Drlg.

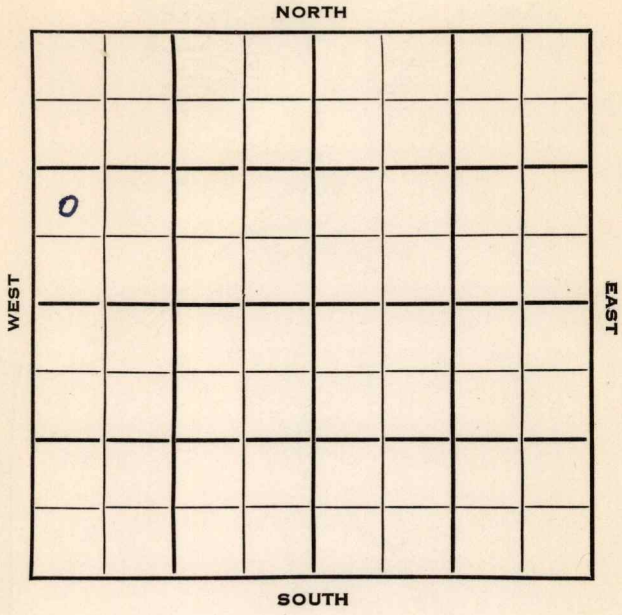

Greenwood KANSAS

SEC.	TWP.	R.
25	25	8E

WELL NO.

#1 Jackson FARM

COMPANY

Bedell & Catt Drlg.

CONTRACTOR

Co. Tools.

Sallyards Pool


_____ Ft. from N. Line

990 Ft. from S. Line

_____ Ft. from E. Line

330 Ft. from W. Line

NW SW NW

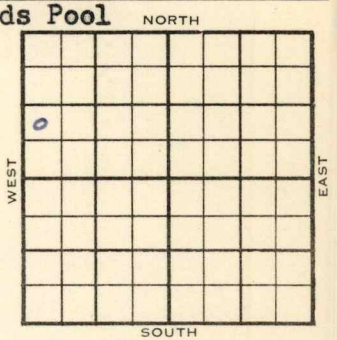

1954	ELEVATION -	REPORT
4/27		R U R
6/9		Spud 4-26-54 Oil Well TD 2461' 8" @ 90' KC 1807', Bart 2444' TD 2459' 5" @ 2445' DD 2461' PB 2458' Hydro S/8 bo 2 bwph 4 hrs. omp. 25 bopd 4 bw

COMPLETED

DX-78

FORM 275 FOR SALE BY KANSAS BLUE PRINT CO.


County Greenwood State Kansas

Sec. 25 (Blk. Twp.) 25 (Sur. Rge.) 8E Map No.

Operator Bedell & Catt Drlg.

Well No. 1 Farm Jackson

Elev. Location NW SW NW

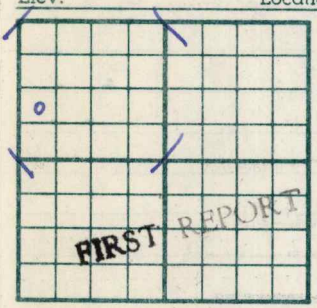

990 Ft. From S Line NW

330 Ft. From W Line Quarter

APR 27 1954

1st. Report

Completion

Remarks Co. tools

Spudding Date

Drlg. Data Sallyards Pool

R U R

J. G. McGEHEE

FORM 275 FOR SALE BY KANSAS BLUE PRINT CO.


County Greenwood State Kansas

Sec. 25 (Blk. Twp.) 25 (Sur. Rge.) 8E Map No.

Operator Bedell & Catt Drlg.

Well No. 1 Farm Jackson

Elev. Location NW SW NW

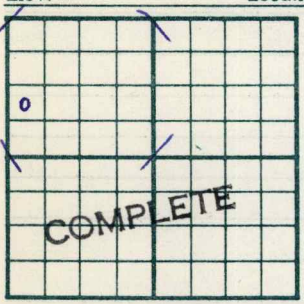

990 Ft. From S Line NW

330 Ft. From W Line Quarter

1st. Report

Completion JUN 9 1954

Remarks Sallyards Pool
Co. tools

Spudding Date 4-26-54

Drlg. Data Oil well TD 2461

8" @ 90 KC 1807 Bart. 2444

TD 2459 5" @ 2445 DD 2461 PB 2458

Hydro. S/ 8 bo 2 bwph 4 hr.

Comp. 25 bopd 4 bw

J. G. McGEHEE