


Map No. **KANSAS** Sec. *4* Twp. *27* R. *1E*
 Well No. *1- Skinner Collins et al* Farm _____ Company _____

NORTH

WEST

EAST

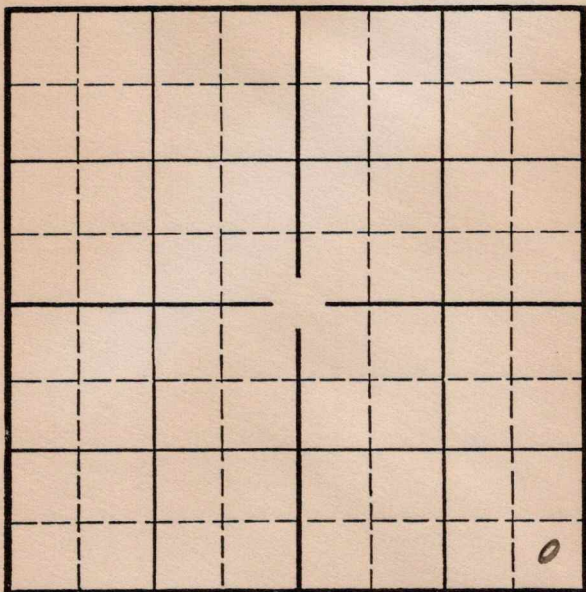

SOUTH

Location _____
 Drilling Remarks _____

Rig Up _____
 Drilling Remarks _____

RECORD

Cased _____ in. _____ ft.
 Sand _____
 Gas _____
 Oil _____
 Total Depth _____

PRODUCTION


1st 24 hrs. Nat. _____
 1st 24 hrs. after shot _____
 Gas _____ cu. ft. _____
 Dry Hole _____
 Abandoned _____

Sedgwick
27 *16*

Map No. Sec. 4 Twp. 27 R. 16

Well No. 1- Skinner Farm
Collins et al Company

NORTH

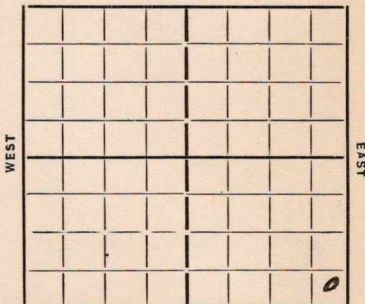

SOUTH

Ft. from N. Line

330

Ft. from S. Line

330

Ft. from E. Line

Ft. from W. Line

Elev. 1313

Date *11/35*

REPORT

11/30 Location

11/29

12/6 Dlg 600

12/7

12/19 SD 600

12/36 1/2/36

1/10 Dlg 522

1/17 TD 522 SD.

1/24

1/29 TD 522 Abandoned.

ABANDONED

KANSAS

Map No. 12 Sec. 4 Twp. 27 R. 18Well No. 1-SkinnerCollins et al Company

Contractor

FIRST REPORTS

SECTION PLAT

			0

Ft. from N. Line

330 Ft. from S. Line330 Ft. from E. Line

Ft. from W. Line

Location ✓

Rig up

Drilling and Remarks:

RECORD

Cased.....in.,ft.

Sand.....

Gas.....

Oil.....

Total Depth.....

PRODUCTION

1st 24 hrs. Nat.....

1st 24 hrs. after shot.....

Gas.....Cu. Ft.

Dry Hole.....

Abandoned.....

Date

11-20-35 192

ORVAL MANNSCHRECK

Scout


KANSAS

Map No. 12 Sec. 4 Twp. 27 R. 1 EWell No. 1 - SkinnerCollins et al Company

Contractor

ABANDONED

SECTION PLAT

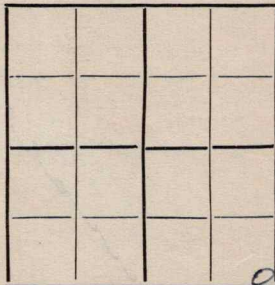

Ft. from N. Line

330 Ft. from S. Line330 Ft. from E. Line

Ft. from W. Line

Location

Rig up

Drilling and Remarks:

abd Loc

RECORD

Cased _____ in., _____ ft.

Sand _____

Gas _____

Oil _____

Total Depth 522

PRODUCTION

1st 24 hrs. Nat. _____

1st 24 hrs. after shot _____

Gas _____ Cu. Ft.

Dry Hole _____

Abandoned _____

Date

ORVAL MANNSCHRECK

1-29-36 192 _____ Scout