


Section 25 Township 25 Range 8-E

Well No. #3 Jackson

Company McGinnis et al

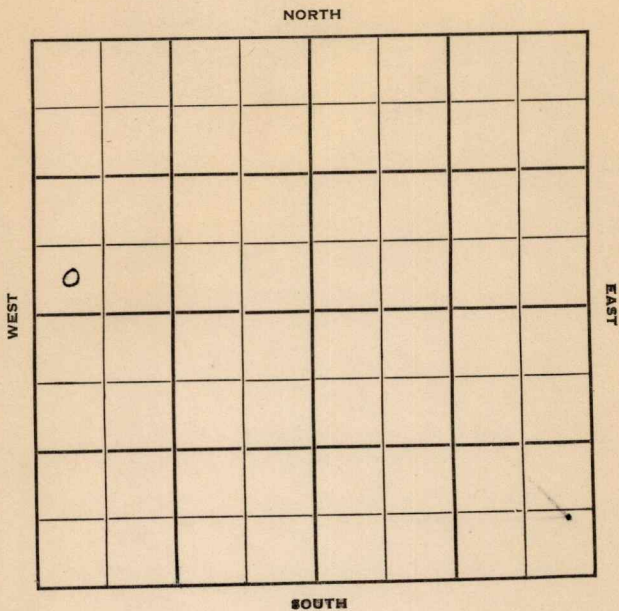

Greenwood **KANSAS**

Sec. 25 Twp. 25 R. 8E

Well No. #3 Jackson Farm

McGinnis et al Company

Sunflower Contractor

Miscellaneous


Ft. from N. Line

330' Ft. from S. Line

Ft. from E. Line

330' Ft. from W. Line

SW SW NW

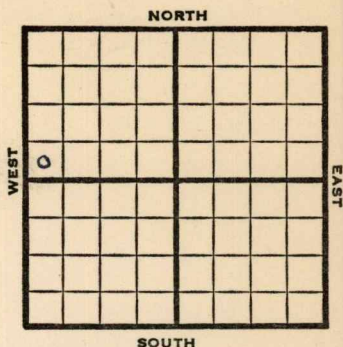

1950

?

REPORT

9/20

Coring @ 2330'

10/18

Cattleman sand 2329-49

4 1/2" @ 2331

TD 2350

40 qt 2329-49

Comp 20 bopd

Completed

COMPLETED

County Greenwood State Kansas
 Sec. 25 (Blk.
Twp.) 25 (Sur.
Rge.) 8E Map No.
 Operator McGinnis et al.
 Well No. 3 Farm Jackson
 Elev. Location SW SW NW

0							

330 Ft. From S Line NW
330 Ft. From W Line Quarter

1st. Report

Completion OCT 18 1950

Remarks

Sunflower Drlg. - Contr.

Spudding Date

Drlg. Data Oil well TD 2350

Cattleman sand 2329-49 4 $\frac{1}{2}$ " @ 2331

TD 2350 40 qt. 2329-49 Comp. 20 bopd

J. E. TYRA

County **Greenwood** State **Kansas**Sec. **25** (Blk.) **25** (Sur.) **8E** Map No.Operator **McGinnis etal.**Well No. **3** Farm **Jackson**Elev. Location **SW SW NW**

0							

330 Ft. From **S** Line **NW****330** Ft. From **W** Line Quarter1st. Report **SEP 20 1950**

Completion

Remarks

Spudding Date

Drlg. Data **Miscellaneous****Coring @ 2330****J. E. TYRA**