

Section 25 Township 25 Range 8-EWell No. #1 LaddCompany G. Cowherd etal

0							

NORTH

WEST

EAST

SOUTH

KANSAS

Greenwood

Sec. 25 Twp. 25 R. 6E ✓

Well No. #1 Ladd Farm

C. Cowherd et al Company

Sunflower Drlg. - Contr. Contractor

Sallyards


330' Ft. from N. Line

_____ Ft. from S. Line

_____ Ft. from E. Line

330' Ft. from W. Line

NW NW SW

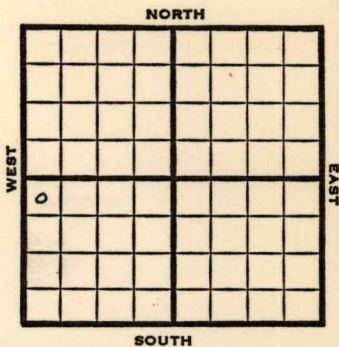

1950

REPORT

12/27

Spud 12-8-50

Bart 2395


TD 2416

D&A

FIRST REPORT

ABANDONED

County Greenwood State Kansas
Sec. 25 (Blk. 25 (Sur. 8E Map No.
Operator C. Cowherd et al.
Well No. 1 Farm Ladd
Elev. Location NW NW SW

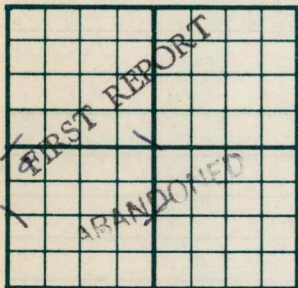

330 Ft. From N Line SW
330 Ft. From W Line Quarter
1st. Report DEC 27 1950
Completion DEC 27 1950
Remarks
Sunflower Drlg. - Contr.
Spudding Date 12-8-50

Drlg. Data Sallyards Pool
Bart. 2395 TD 2416 D & A

J. E. TYRA