


Greenwood

Map No. **KANSAS** Sec. **26** Twp. **25** R. **8E**

Well No. **#3 Jackson** Farm
S.A. Mc Ginnis Company

NORTH

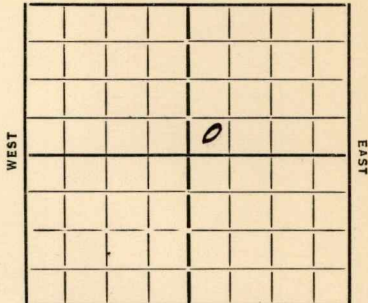

_____ Ft. from N. Line

330 Ft. from S. Line

_____ Ft. from E. Line

330 Ft. from W. Line

SW SW NE

Date **7/35**

REPORT

4/24 Machine
5/2 Spud
5/9 ddy 600
5/16 " 1230
5/23 " 1455
5/29 " 1755
6/5 Rank 2455-65
 T 2500
 D. O. A.

ABANDONED

Map No. 15 Sec. 26 Twp. 25 R. 8 E

Well No. 1-Jackson

McGinnis Company

Contractor

FIRST REPORT

SECTION PLAT

..... Ft. from N. Line

330 Ft. from S. Line

..... Ft. from E. Line

330 Ft. from W. Line

		0	

Location.....

Rig up.....

Drilling and Remarks:

Machine

RECORD

Cased..... in., ft.

Sand.....

Gas.....

Oil.....

Total Depth.....

PRODUCTION

1st 24 hrs. Nat.....

1st 24 hrs. after shot.....

Gas..... Cu. Ft.

Dry Hole.....

Abandoned.....

Date

4-24-30

192 ORVAL MANN SCHRECK

Scout

Map No. 15 Sec. 26 Twp. 25 R. 8E

Well No. 1-Jackson

McGinnis

Company

Contractor

ABANDONED

SECTION PLAT

		0	

Ft. from N. Line

330 Ft. from S. Line

Ft. from E. Line

330 Ft. from W. Line

RECORD

Location.....

Cased..... in., ft.

Rig up.....

Sand. 2455-65

Drilling and Remarks:

Gas.....

Oil.....

Total Depth. 2500

PRODUCTION

1st 24 hrs. Nat.....

1st 24 hrs. after shot.....

Gas..... Cu. Ft.

Dry Hole.....

Abandoned.....

Date

ORVAL MANNSCHECK

6-5-35

192.....

Scout

W + A

O.W.W.O.

FORM 513 SUNRAY

County Greenwood Elev. _____
 Sec. 26 Twp. 25 Rge. 8E
 Company S. A. McGinnis (was Ward McGinnis)
 Farm Name Jackson Est. (was #1) No. 3

TOPS	DEPTH	LOG	DATUM	Loc. in Sec.
Anh.				SW SW NE
Tp.				
H.				<u>OWWO</u>
Tr.				
Dg.				
Bl.				
L.				Geol. <u>O.W.W.O.</u>
K.C.				
B.K.C.				Contr.
Ce.				
C. <u>Bart.</u>	<u>2460</u>			
M.	<u>2600</u>			
M.				Pool
K.				
Mz.				<u>Sallyards</u>
Me.				
V.				
S.				
S.				
A.				
R.				
Pe.				
G.				
T.D.	<u>2610</u>			

FIRST REPORT

JUL 10 '57

Date Comm. OTD 2500 4" @ 2610 CO 48/ 2460-72
to frac

~~30~~

Co. Lse. No. Sec. T. R.

County Greenwood Elev. _____
 Sec. 26 Twp. 25 Rge. 8E
 Company S. A. McGinnis (was Ward McGinnis)
 Farm Name Jackson Est. (was #1) No. 3

TOPS	DEPTH	LOG	DATUM	Loc. in Sec.
Anh.				SW SW NE
Tr.				OWWO
H.				
Tr.				
Dg.				
Bl.				
L.				Geol. _____
K.C.				Contr. _____
B.K.C.				
C. <u>Bart.</u>	<u>2460</u>			
M.	<u>2600</u>			
M.				Pool _____
K.				Sallyards _____
Mz.				
Me.				
V.				
S.				
S.				
A.				
R.				
PE.				
G.				
T.D.	<u>2610</u>			

COMPLETE
 JUL 31 '57

Date Comm. OTD 2500 4" @ 2610 CO 48/ 2460-72
to frac JUL 17 '57 Frac & Ld. JUL 24 '57
JUL 31 '57 est p. 25 Bopd nolw

Co. _____
 Use. _____
 No. _____
 Sec. _____
 T. _____
 R. _____