

Greenwood.


DX 78-1

KANSAS

Section 26 Township 25S Range 8E

Well No. #1 Ladd.

Company T.O. Lilystrand Jr.

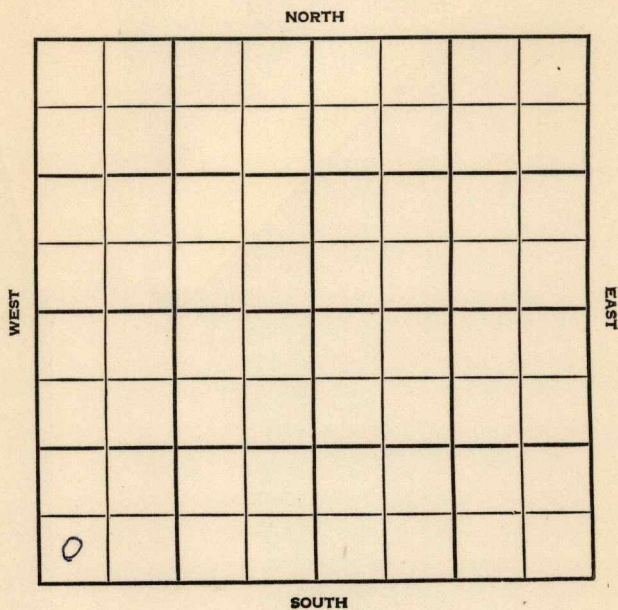

SEC.	TWP.	R.
26	25S	8E

WELL NO.

1 Ladd

FARM

COMPANY

T. O. Lilystrand, Jr.

CONTRACTOR

White & Ellis


_____ Ft. from N. Line

330 _____ Ft. from S. Line

_____ Ft. from E. Line

330 _____ Ft. from W. Line

SW SW SW

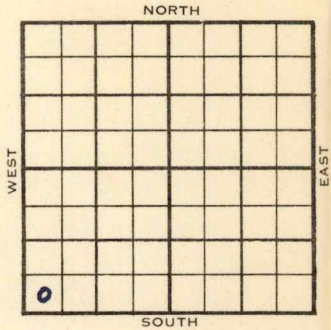

1954

ELEVATION

REPORT

12/8

Spud 11-30-54

1955
2/2

Spud 11-30-54 - Oil Well

TD 2484'

Lans. 1530', KC 1832', Bart. 2462'

TD 2484'

5" @ 2464'

CO to 2468, frac.

P/25 bopd

P/7 bo 3 bwpd

CO to 2468, frac.

Comp. 15 bopd 4 bw

COMPLETED

County Greenwood State Kansas

Sec. **26** (Blk. **25S** (Sur. **8E** Map No.

Operator T. O. Lilystrand Jr.

Well No. 1 Farm Ladd

Elev.	Location	SW	SW	SW
-------	----------	----	----	----

FIRST REPORT

330 Ft. From S Line

330 Ft. From W Line SW Quarter

1st. Report DEC 8 1954

Completion

Remarks White & Ellis tools

Spudding Date 11-30-54

Drig. Data

FABEN GILSTRAP

County Greenwood State Kansas
 Sec. 26 (Blk.) 25 (Sur.) 8E Map No.
 Operator T. O. Lilystrand Jr.
 Well No. 1 Farm Ladd
 Elev. _____ Location SW SW SW

0					

330 Ft. From S Line SW
330 Ft. From W Line Quarter

1st. Report

Completion FEB 2 1955

Remarks

White & Ellis - Contr.

Spudding Date 11-30-54

Drlg. Data Oil well TD 2484
Lans. 1530 KC 1832 Bart. 2462 TD 2484
5" @ 2464 CO to 2468 frac
P/ 25 bopd P/ 7 bo 3 bwpd CO to 2468
frac Comp. 15 bopd 4 bw

FABEN GILSTRAP