


Map No. _____, Sec. 27 Twp. 25 R. 8

Well No. 1 Robins Farm _____
Pothamus Etal Company

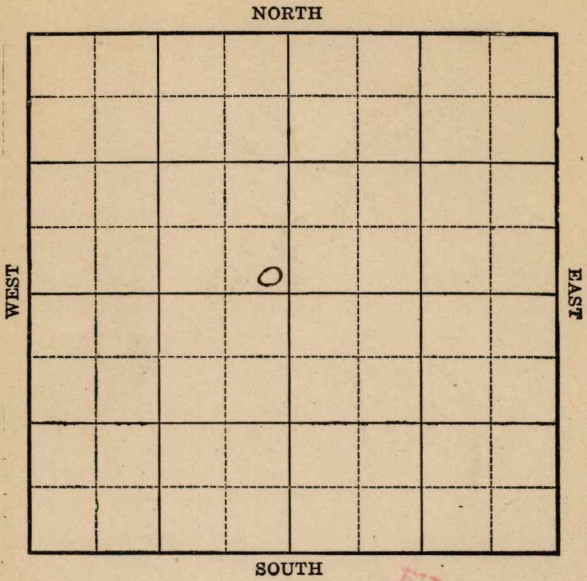

FIRST REPORT

Location _____

Drilling Remarks:

Rig up _____

Drilling Remarks:

RECORD

Cased _____ in. _____ ft.

Sand _____

Gas _____

Oil _____

Total Depth _____

PRODUCTION

1st 24 hrs Nat. _____

1st 24 hrs. after shot _____

Gas _____ cu. ft.

Dry Hole _____

Abandoned _____

Map No. _____ Sec. 27 Twp. 25 R. 8


Well No. 1 Robins Farm
Polhamus Etal Company

_____ Ft. from N. Line

200 Ft. from S. Line

200 Ft. from E. Line

_____ Ft. from W. Line

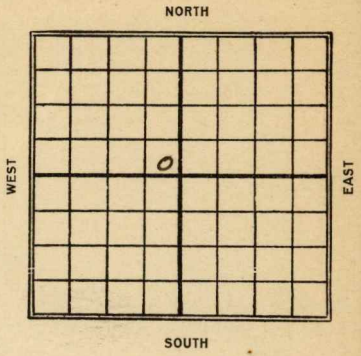

Date
1923

REPORT

1/6

Dlg. 1385'

1/12

Abandoned 2670'

KANSAS

Map No. _____ Sec. 27 Twp. 25 R. 8

Well No. 1 *Rafines*

Palhamus et al Company

Contractor

FIRST REPORT

SECTION PLAT

_____ Ft. from N. Line

200 Ft. from S. Line

200 Ft. from E. Line

_____ Ft. from W. Line

Location _____

Rig up

Drilling and Remarks:

July 13 25

RECORD

Cased _____ in., _____ ft.

Sand _____

Gas _____

Oil _____

Total Depth _____

PRODUCTION

1st 24 hrs. Nat. _____

1st 24 hrs. after shot _____

Gas _____ Cu. Ft.

Dry Hole _____

Abandoned _____

Date

JAN 6 1923

M. A. BENEAR

191

Scout

Map No. **KANSAS** Sec. **27** Twp. **25** R. **8**

Well No. **1 - Rafins**
Palhamus Company

Contractor

ABANDONED SECTION PLAT

----- Ft. from N. Line
200 Ft. from S. Line
200 Ft. from E. Line
----- Ft. from W. Line

Location -----
Rig up -----
Drilling and Remarks:

RECORD

Cased ----- in., ----- ft.
Sand -----
Gas -----
Oil -----
Total Depth **26** -----

PRODUCTION

1st 24 hrs. Nat. -----
1st 24 hrs. after shot -----
Gas ----- Cu. Ft.
Dry Hole -----
Abandoned **2670'** -----

Date

JAN 12 1923

M. A. BENEAR

----- 191 ----- Scout