


Map No. _____ Sec. 26 Twp. 25 R. 8
Well No. 1 Jackson Farm _____
Vickers & Johnson Company _____

NORTH

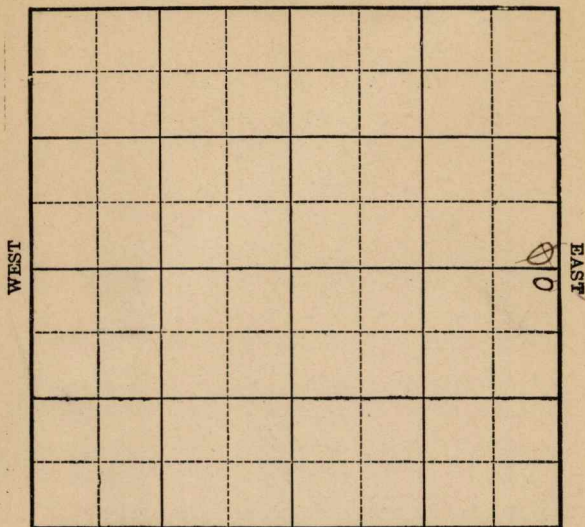

SOUTH

Location _____

Drilling Remarks:

Rig up _____

Drilling Remarks:

RECORD

Cased _____ in. _____ ft.

Sand _____

Gas _____

Oil _____

Total Depth_____

PRODUCTION

1st 24 hrs Nat. _____

1st 24 hrs. after shot_____

Gas _____ cu. ft.

Dry Hole _____

Abandoned _____

Map No. _____ Sec. 26 Twp. 25 R. 8


Well No. 1 Jackson Farm
Vickers & Johnson Company

_____ Ft. from N. Line

200 Ft. from S. Line

200 Ft. from E. Line

_____ Ft. from W. Line

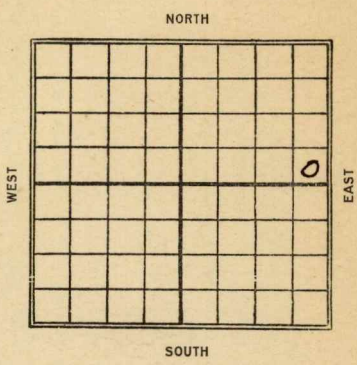

Date
1923
1/12
4/20

REPORT

Location.

D + 9.2795'

Map No. ¹⁵ ~~KANSAS~~ Sec. ²⁶ Twp. ²⁵ R. ⁸Well No. ¹ *Jackson**Vickers & Johnson* Company

Contractor

FIRST REPORT

SECTION PLAT

Ft. from N. Line

200' Ft. from S. Line*200'* Ft. from E. Line

Ft. from W. Line

Location *✓✓*

Rig up

Drilling and Remarks:

RECORD

Cased _____ in., _____ ft.

Sand _____

Gas _____

Oil _____

Total Depth _____

PRODUCTION

1st 24 hrs. Nat. _____

1st 24 hrs. after shot _____

Gas _____ Cu. Ft.

Dry Hole _____

Abandoned _____

Date

JAN 12 1923

M. A. BENEAR

191

Scout

Map No. **KANSAS** ¹⁵ Sec. **26** Twp. **25** R. **8**Well No. **1 Jackson**
Wickers & Johnson Company

Contractor

ABANDONED SECTION PLAT**200** Ft. from N. Line

Ft. from S. Line

200 Ft. from E. Line

Ft. from W. Line

			50

Location

Rig up

Drilling and Remarks:

LOV9
2795**RECORD**

Cased _____ in., _____ ft.

Sand _____

Gas _____

Oil _____

Total Depth _____

PRODUCTION

1st 24 hrs. Nat. _____

1st 24 hrs. after shot _____

Gas _____ Cu. Ft.

Dry Hole _____

Abandoned _____

Date

APR 20 1923**M. A. BENEAR**

191

Scout