


Map No. K14 Sec. 35 Twp. 26 R. 5
 Well No. 1 Bismarck Farm
? Company

NORTH

WEST

EAST

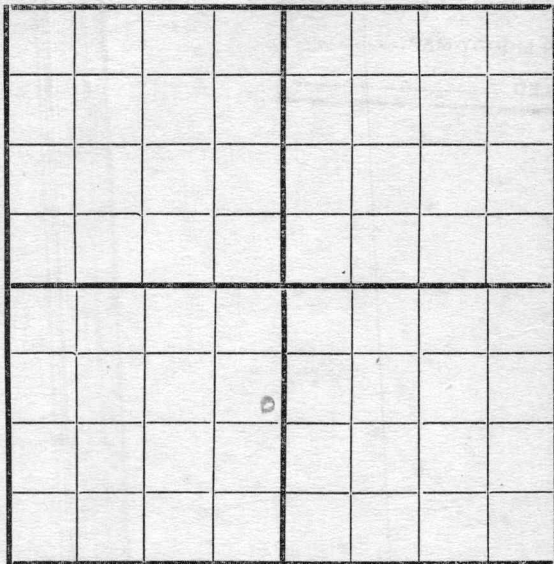

SOUTH

Location ✓Rig Up ✓

Drilling and remarks

RECORD

Cased _____ in. _____ Ft.

Sand _____

Gas _____

Oil _____

Total Depth _____

PRODUCTION

1st 24 hrs. Nat. _____

1st 24 hrs. after shot _____

Gas _____ Cu. Ft.

Dry Hole _____

Abandoned _____

Date

4/5, 191 7 Cordy Scout

FIRST REPORT

Map No. _____ Sec. 35 Twp. 26 R. 5Well No. 1 Bisagno Farm _____

Company _____

NORTH

WEST

EAST

SOUTH

Location _____

Rig Up _____

Drilling and remarks

Spudding

RECORD

Cased _____ in. _____ Ft.

Sand _____

Gas _____

Oil _____

Total Depth _____

PRODUCTION

1st 24 hrs. Nat. _____

1st 24 hrs. after shot _____

Gas _____ Cu. Ft.

Dry Hole _____

Abandoned _____


Date

4/11, 1917

Scout

Map No. _____ Sec. 35 Twp. 26 R. 5
 Well No. 1 Bisagua Farm _____
 _____ Company _____

NORTH

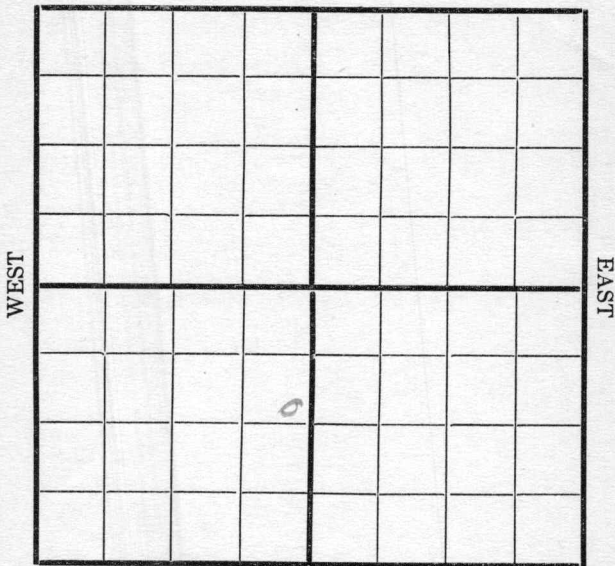

SOUTH

Location _____
 Rig Up _____
 Drilling and remarks _____

880'

RECORD

Cased _____ in. _____ Ft.
 Sand _____
 Gas _____
 Oil _____
 Total Depth _____

PRODUCTION


1st 24 hrs. Nat. _____
 1st 24 hrs. after shot _____
 Gas _____ Cu. Ft.
 Dry Hole _____
 Abandoned _____

Date

4/19 1917 C. Carey Scout

Map No. _____ Sec. 35 Twp. 26 R. 5
 Well No. 1 Biangu Farm _____
 _____ Company _____

NORTH

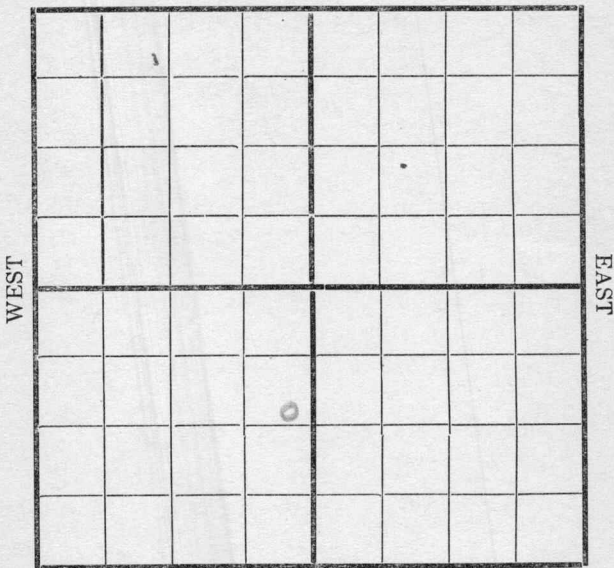

SOUTH

Location _____
 Rig Up _____
 Drilling and remarks _____

RECORD

Cased _____ in. _____ Ft.
 Sand _____
 Gas _____
 Oil _____
 Total Depth _____

PRODUCTION


1st 24 hrs. Nat. _____
 1st 24 hrs. after shot _____
 Gas _____ Cu. Ft.
 Dry Hole _____
 Abandoned _____

Date

4/26 191 2 Land Scout

Map No. _____ Sec. 35 Twp. 26 R. 5Well No. 1 Bisanyo Farm _____Sawyer et al Company _____

NORTH

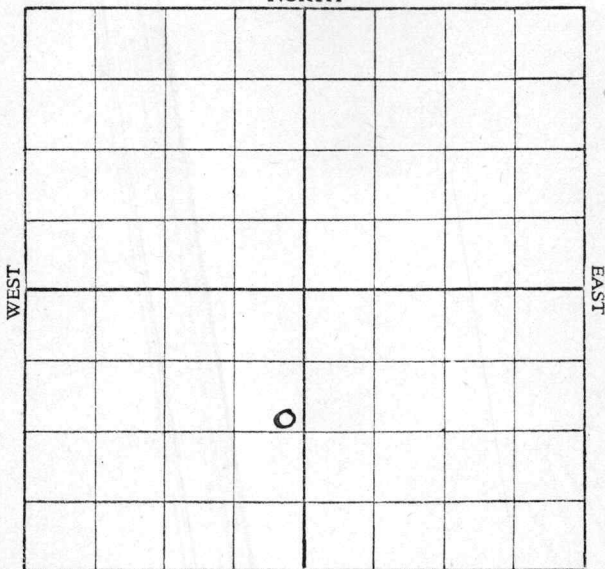

SOUTH

Location _____

Rig up _____

Drilling and remarks:

D-1700'

RECORD

Cased _____ in. _____ Ft.

Sand _____

Gas _____

Oil _____

Total Depth _____

PRODUCTION

1st 24 hrs. Nat. _____

1st 24 hrs. after shot _____

Gas _____ Cu. Ft.

Dry Hole _____

Abandoned _____

Date

5/5, 1917, Crocker Scout

Map No. _____ Sec. 35 Twp. 26 R. 5

Well No. 1 Bisango Farm

Sawyer et al Company
NORTH

WEST EAST

SOUTH

Location _____

Rig up _____

Drilling and remarks:

D-1825'

RECORD

Cased _____ in. _____ Ft.

Sand _____

Gas _____

Oil _____

Total Depth _____

PRODUCTION

1st 24 hrs. Nat. _____

1st 24 hrs. after shot _____


Gas _____ Cu. Ft.

Dry Hole _____

Abandoned _____

Date

5/12, 1917, Crocker Scout

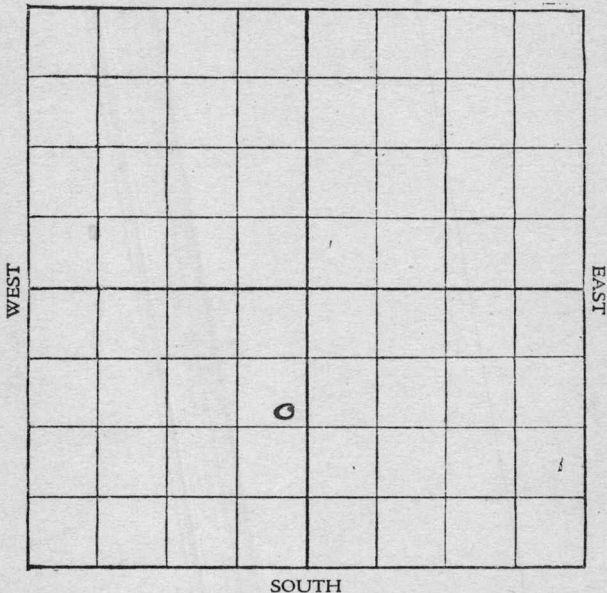Map No. _____ Sec. 35 Twp. 26 R. 5Well No. 1 Bisango FarmSawyer et al Company
NORTH

Location _____

Rig up _____

Drilling and remarks:

2260'-2265'Show oil.Dry @ 2370'

RECORD

Cased _____ in. _____ Ft.

Sand _____

Gas _____

Oil _____

Total Depth _____

PRODUCTION

1st 24 hrs. Nat. _____

1st 24 hrs. after shot _____

Gas _____ Cu. Ft.

Dry Hole _____

Abandoned _____

Date


5/19, 1917, Crocker Scout

Map No. _____ Sec. 35 Twp. 26 R. 5

Well No. 1 Bisango Farm _____

Sawyer et al Company _____

NORTH

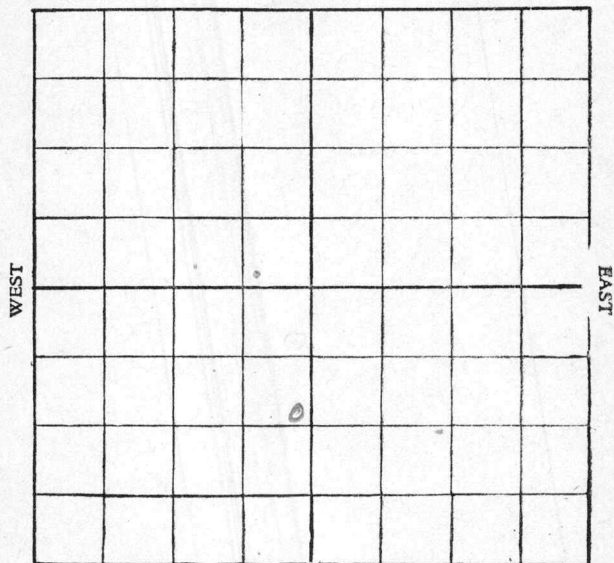

SOUTH

Location _____

Rig up _____

Drilling and remarks:

S.D. 2550

RECORD

Cased _____ in. _____ Ft.

Sand _____

Gas _____

Oil _____

Total Depth _____

PRODUCTION

1st 24 hrs. Nat. _____

1st 24 hrs. after shot _____

Gas _____ Cu. Ft.

Dry Hole _____

Abandoned _____

Date


7/26, 1917, Crocker Scout

Map No. _____ Sec. 35 Twp. 26 R. 5
 Well No. 1 Bisango Farm _____
Sawyer et al Company _____

NORTH

WEST

EAST

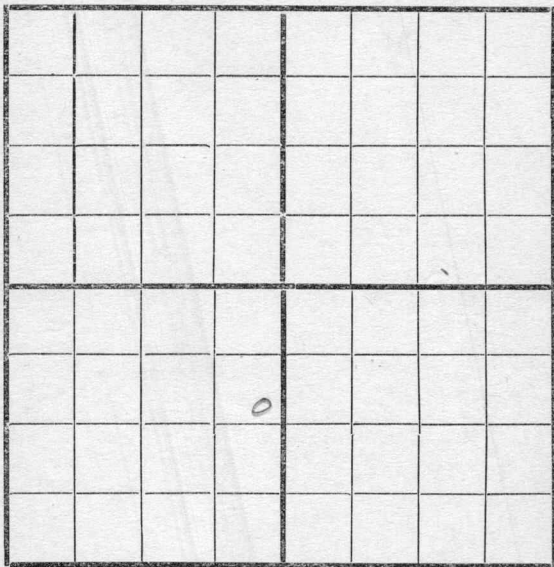

SOUTH

Location _____

Rig Up _____

Drilling and remarks

U.R. 2712No Sand

RECORD

Cased _____ in. _____ Ft.

Sand _____

Gas _____

Oil _____

Total Depth _____

PRODUCTION

1st 24 hrs. Nat. _____

1st 24 hrs. after shot _____

Gas _____ Cu. Ft.

Dry Hole _____


Abandoned _____

Date

10/2, 1917 Crocker Scout

Map No. _____ Sec. 35 Twp. 26 R. 5Well No. 1 Bisang 0 Farm _____Sawyer et al Company _____

NORTH

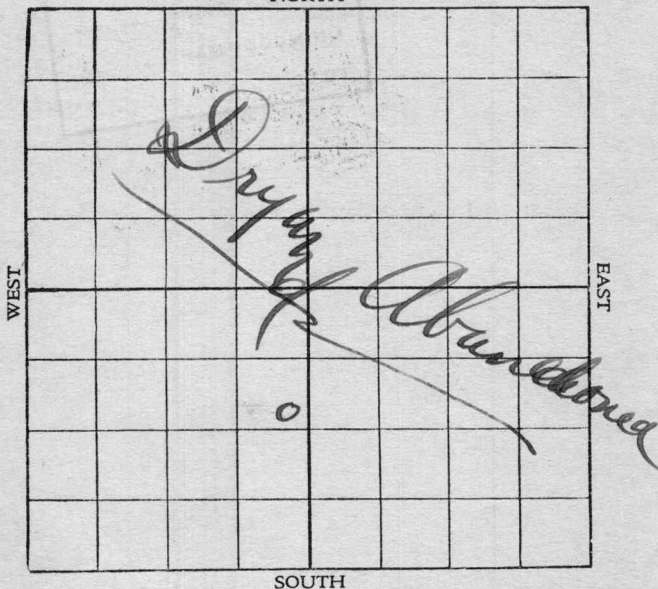

SOUTH

Location _____

Rig up _____

Drilling and remarks:

RECORD

Cased _____ in. _____ Ft.

Sand _____

Gas _____

Oil _____

Total Depth 2778

PRODUCTION

1st 24 hrs. Nat. _____

1st 24 hrs. after shot _____

Gas _____ Cu. Ft.

Dry Hole ☒Abandoned ☒

Date

JUN 9 - 1917

191

Scout

C. J. Crocker