


KANSAS

Butler County

Section 12 Township 25S Range 7E

Well No. #1 Colombian Hog & Cattle

Company Ward McGinnis et al

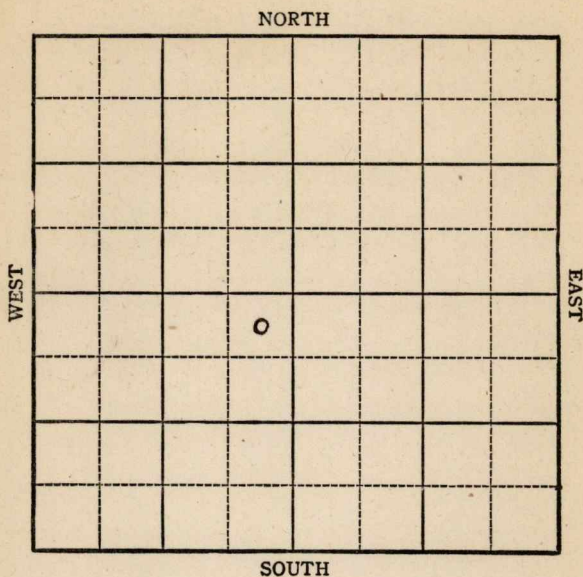

KANSAS

Butler County

Sec. 12 Twp. 25 R. 7E

Well No. #1, Colombian Hog & Cattle Farm

Ward McGinnis et al Company


Miscellaneous

330 Ft. from N. Line

Ft. from S. Line

330 Ft. from E. Line

Ft. from W. Line

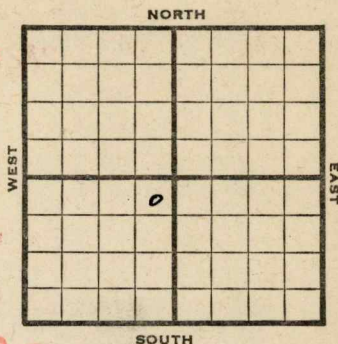

NE SW

Elev. 1502

1944

R E P O R T

11-1

8" @ 150'

Lansing 1700'

KC 2050

Miss. 2755

Chat 2793

Total Depth 2818'

FIRST REPORT

[Signature]

ABANDONED

Pool Name MiscellaneousMap No. 15 Sec. 12 Twp. 25 R. 7EWell No. 1 Colombian Hog & CattleWard McGinnis et al Company

FIRST REPORT


anal.

Contractor

NE SW

ABANDONED

SECTION PLAT

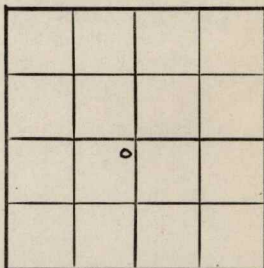330 Ft. from N. Line Ft. from S. Line330 Ft. from E. Line Ft. from W. LineButlerLocation Rig up

Drilling and Remarks:

8"-150Lans 1700KC 2050Miss 2755Chat 2793D & A

RECORD

Cased in., ft.Sand Gas Oil Total Depth 2818

PRODUCTION

1st 24 hrs. Nat. 1st 24 hrs. after shot Gas Cu. Ft.Dry Hole Abandoned

Date

NOV 1 194419S. J. LEWIS Scout