

Map No. _____ Sec. 10 Twp. 20 R. 7

Well No. 1 M. E. Melvin Farm

Condin & Crawford Company

NORTH

WEST

EAST

NORTH

SOUTH

Location _____

Drilling Remarks:

Rig Up

Drilling Remarks:

FIRST REPORT
COMPLETED

RECORD

Cased _____ in. _____ ft.

Sand _____

Gas _____

Oil_____

Total Depth_____

PRODUCTION

1st 24 hrs. Nat. _____

1st 24 hrs. after shot_____

Gas_____cu. ft.

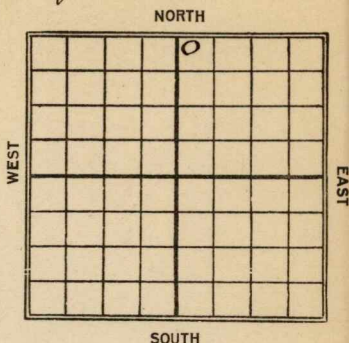
Dry Hole _____

Abandoned _____

Map No. _____ Sec. 15 Twp. 25 R. 7Well No. 1 M. E. Melvin FarmCondit & Crawford Company200 Ft. from N. Line

_____ Ft. from S. Line

_____ Ft. from E. Line

200 Ft. from W. Line

Date

REPORT

19229/16R.O.S.11/24D. & A. 2830'

Map No. **KANSAS** ¹⁵ Sec. ¹⁵ Twp. ²⁵ R. ⁷Well No. ¹ *M. E. Melvin*
Condin & Crawford Company

Contractor

FIRST REPORT

SECTION PLAT

200 Ft. from N. Line

Ft. from S. Line

Ft. from E. Line

200 Ft. from W. Line

		o	

Location -----

Rig up -----

Drilling and Remarks:

R.O. G

RECORD

Cased ----- in., ----- ft.

Sand -----

Gas -----

Oil -----

Total Depth -----

PRODUCTION

1st 24 hrs. Nat. -----

1st 24 hrs. after shot -----

Gas ----- Cu. Ft.

Dry Hole -----

Abandoned -----

Date

SEP 16 1922

191

M. A. BENEAR

Scout

Map No. **KANSAS** ⁵ Sec. **15** Twp. **25** R. **7**Well No. **1** **McPherson**
Condon & Crawford Company

Contractor

ABANDONED SECTION PLAT**200** Ft. from N. Line

Ft. from S. Line

Ft. from E. Line

200 Ft. from W. Line

		0	

RECORD

Location

Cased _____ in., _____ ft.

Rig up

Sand _____

Drilling and Remarks:

Gas _____

Oil _____

Total Depth _____

PRODUCTION

1st 24 hrs. Nat. _____

1st 24 hrs. after shot _____

Gas _____ Cu. Ft.

Dry Hole _____

Abandoned **2830**

Date

NOV 24 1929

M. A. BENEAR

Scout