


Well No. 1 White Farm
J. H. Leggett Company

NORTH

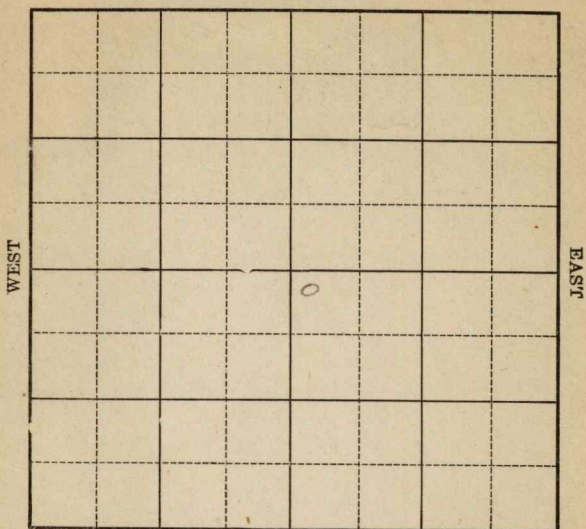

SOUTH

Location

Drilling Remarks

Rig Up

Drilling Remarks

RECORD

Cased _____ in. _____ ft.

Sand

Gas _____

Oil

Total Depth -----

PRODUCTION

1st 24 hrs. Nat. _____

1st 24 hrs. after shot _____

Gas _____ cu. ft.

Dry Hole

Abandoned

Butler Co

Map No. Kansas Sec. 22 Twp. 25 R 7Well No. 1 White FarmJ. H. Leggett Company

NORTH

WEST


EAST

SOUTH

250 Ft. from N. Line

_____ Ft. from S. Line

_____ Ft. from E. Line

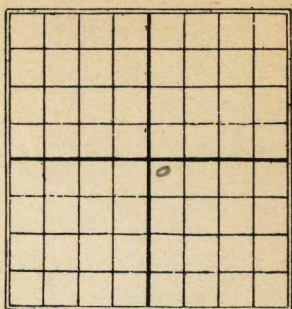250 Ft. from W. Line

Date

REPORT

<u>1925</u>	
<u>12/17</u>	<u>Reg up</u>
<u>12/23</u>	<u> </u>
<u>12/31</u>	<u> </u>
<u>1926</u>	
<u>1/8</u>	<u> </u>
<u>1/14</u>	<u> </u>
<u>1/20</u>	<u> </u>
<u>1/27</u>	<u> </u>
<u>2/3</u>	<u> </u>
<u>2/10</u>	<u> </u>
<u>2/17</u>	<u>Spudding.</u>
<u>2/24</u>	<u>Dlg 250'</u>
<u>3/5</u>	<u>S.D. 500'</u>
<u>3/10</u>	<u>Dlg 900</u>
<u>3/18</u>	<u>" 1400</u>
<u>3/25</u>	<u>" 1735</u>
<u>4/1</u>	<u>" 1900</u>
<u>4/7</u>	<u>S.D. - 200</u>
<u>4/14</u>	<u> </u>
<u>4/21</u>	<u>Running 6" 2335'</u>
<u>4/30</u>	<u>NR 5" 2585</u>
<u>5/8</u>	<u>S.D. 2585</u>
<u>6/2</u>	<u>S.D. 2628</u>

5/12 - S.D. 2585'

5/19

6/2 - S.D. 2628'

6/10 - Drg at 2740'

6/17 - S.D. 2795'

Butler Co

Map No. KANSAS-22 Sec. 25 Twp. 25 R. 7Well No. 1 WhitG. A. Liggitt Company

Contractor

SECTION PLAT

250 Ft. from N. Line

Ft. from S. Line

Ft. from E. Line

250 Ft. from W. Line

FIRST REPORTS

		0	

Location ✓Rig up ✓

Drilling and Remarks:

RECORD

Cased _____ in., _____ ft.

Sand _____

Gas _____

Oil _____

Total Depth _____

PRODUCTION

1st 24 hrs. Nat. _____

1st 24 hrs. after shot _____

Gas _____ Cu. Ft.

Dry Hole _____

Abandoned _____

Date

DEC 17 1925

CHAS. L. SHERWOOD

192

Scout

Button
Map No. *K15* KANSAS Sec. *22* Twp. *25* R. *7*

Well No. *1* *Whit*
J. A. Liggett Company

Contractor

COMPLETED

SECTION PLAT

250 Ft. from N. Line
Ft. from S. Line
Ft. from E. Line
250 Ft. from W. Line

		0	

ABANDONED

Location
Rig up
Drilling and Remarks:
Top line 2763
100
2795

RECORD

Cased _____ in., _____ ft.
Sand _____
Gas _____
Oil _____
Total Depth *2795*

PRODUCTION

1st 24 hrs. Nat. _____
1st 24 hrs. after shot _____
Gas _____ Cu. Ft.
Dry Hole ☒
Abandoned ☒

Date

JUN 17 1926

CHAS. L. SHERWOOD
Scout