


Map No. _____ Sec. 34 Twp. 26 R. 5
 Well No. 1 Kennedy Farm _____
Leonard Oil Company

NORTH

WEST

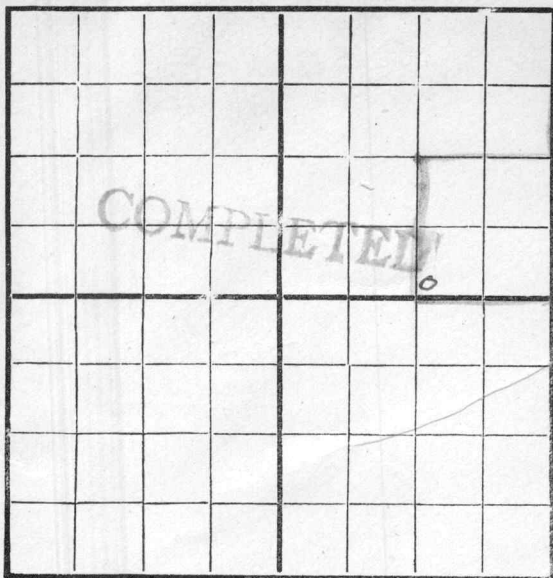

EAST

SOUTH

Location _____

Rig Up _____

Drilling Remarks:

Drilling Remarks:


RECORD

PRODUCTION

Cased _____ in _____ Ft.
 Sand _____
 Gas _____
 Oil _____
 Total Depth _____

1st 24 hrs. Nat. _____
 1st 24 hrs. after shot _____
 Gas _____ Cu. Ft.
 Dry Hole _____
 Abandoned _____

Map No. _____ Sec. 34 Twp. 26 R. 5
 Well No. 1 Kennedy Farm _____
Leonard Oil Company _____
 NORTH

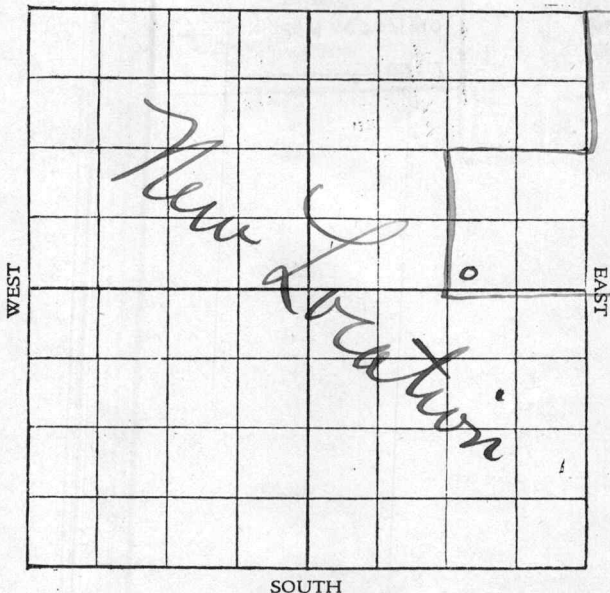

Location _____

Rig up _____

Drilling and remarks:

Rig.

RECORD

Cased _____ in. _____ Ft.

Sand _____

Gas _____

Oil _____

Total Depth _____

PRODUCTION

1st 24 hrs. Nat. _____

1st 24 hrs. after shot _____

Gas _____ Cu. Ft.

Dry Hole _____


Abandoned _____

Date

5/12, 1917 Crocker Scout

Map No. _____ Sec. 34 Twp. 26 R. 5Well No. 1 Kennedy FarmLeonard Oil Company

NORTH

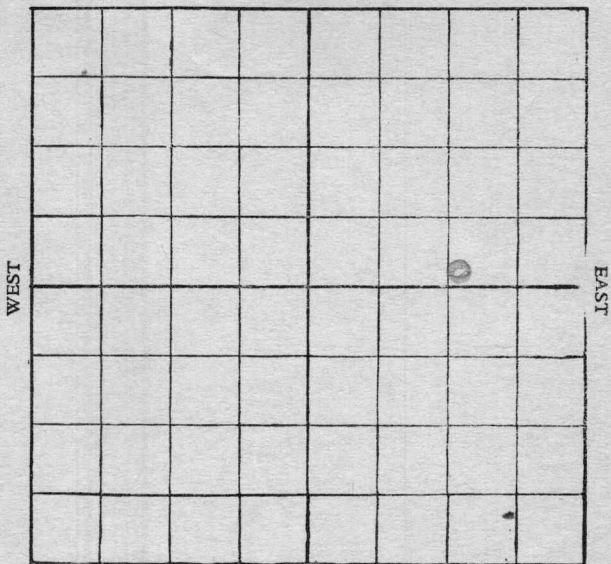

SOUTH

Location _____

Rig up _____

Drilling and remarks:

29-400'

RECORD

Cased _____ in. _____ Ft.

Sand _____

Gas _____

Oil _____

Total Depth _____

PRODUCTION

1st 24 hrs. Nat. _____

1st 24 hrs. after shot _____

Gas _____ Cu. Ft.

Dry Hole _____


Abandoned _____

Date

7/26, 1917, Lawyer Scout

Map No. _____ Sec. 34 Twp. 26 R. 5
Well No. 1 Kennedy _____ Farm

NORTH

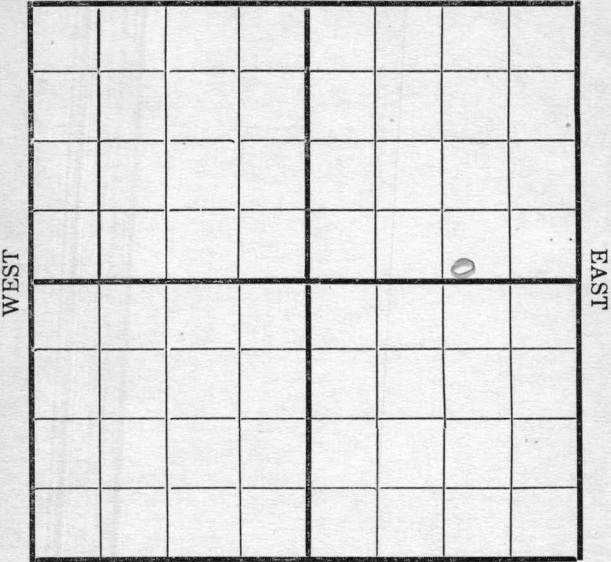

SOUTH


Location _____ Rig Up _____ Drilling and remarks <u>2-1160'</u>	RECORD
	Cased _____ in. _____ Ft.
	Sand _____
	Gas _____
	Oil _____
	Total Depth _____
	PRODUCTION
	1st 24 hrs. Nat. _____
	1st 24 hrs. after shot _____
	Gas _____ Cu. Ft.
	Dry Hole _____
	Abandoned _____

Date 6/2, 1917 Brocker Scout

Map No. _____ Sec. 34 Twp. 26 R. 5Well No. 1 Kennedy Farm
Leonard Oil Company

NORTH

WEST

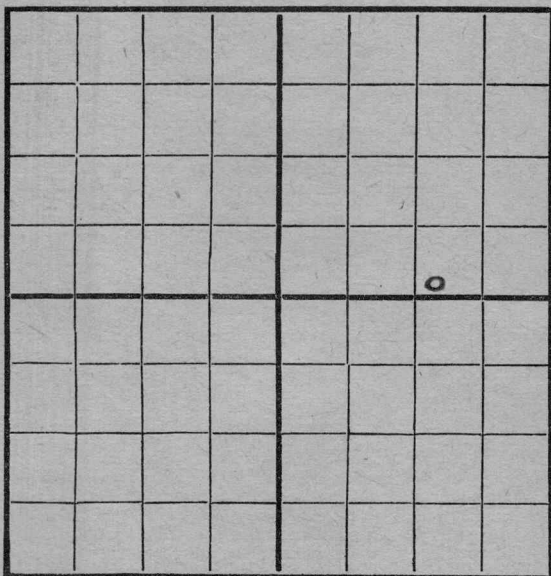

EAST

SOUTH

Location _____

Rig Up _____

Drilling and remarks

81000'

RECORD

Cased _____ in. _____ Ft.

Sand _____

Gas _____

Oil _____

Total Depth _____

PRODUCTION

1st 24 hrs. Nat. _____

1st 24 hrs. after shot _____

Gas _____ Cu. Ft.

Dry Hole _____

Abandoned _____

Date

JUN 16 1917

191


Scout

C. T. Crook

Map No. _____ Sec. 34 Twp. 26 R. 5
 Well No. 1 Kennedy Farm
Levard Oil Company

NORTH

WEST

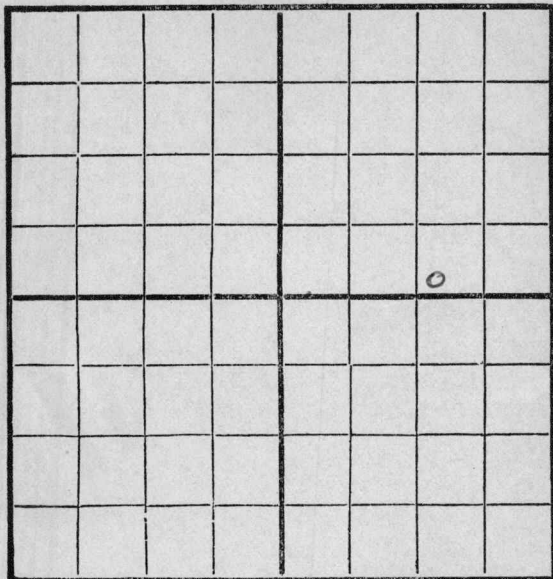

EAST

SOUTH

Location _____

Rig Up _____

Drilling and remarks

2-1000

RECORD

Cased _____ in. _____ Ft.

Sand _____

Gas _____

Oil _____

Total Depth _____

PRODUCTION

1st 24 hrs. Nat. _____

First 24 hrs. after shot _____

Gas _____ Cu. Ft.

Dry Hole _____

Abandoned _____


Date

JUN 22 1917

191

E. J. Crocker
Scout

Map No. _____ Sec. 34 Twp. 26 R. 5
Well No. 1 Kennedy Farm
Leased Oil Company

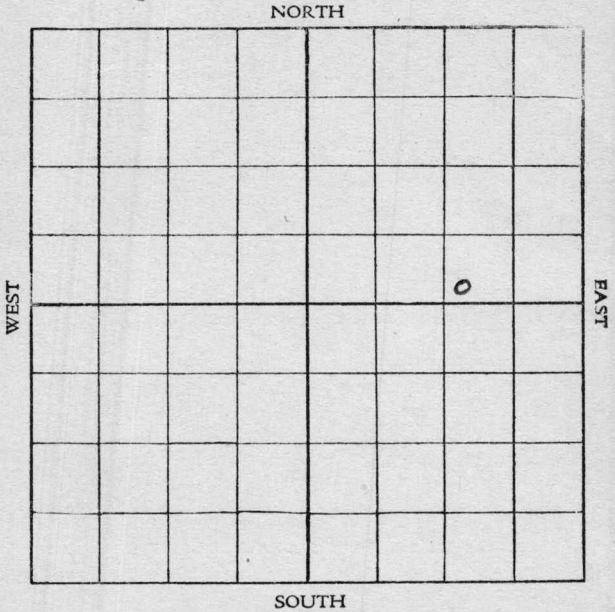


Location _____	RECORD
Rig up _____	Cased _____ in. _____ Ft.
Drilling and remarks:	Sand _____
<u>Hole full of</u>	Gas _____
<u>water</u>	Oil _____
<u>5 - 1850</u>	Total Depth _____
	PRODUCTION
	1st 24 hrs. Nat. _____
	1st 24 hrs. after shot _____
	Gas _____ Cu. Ft.
	Dry Hole _____
	Abandoned _____

Date JUN 30 1917
B. J. Crocker Scout

Map No. _____ Sec. 34 Twp. 26 R. 5

Well No. 1 Kennedy Farm
Leonard Oil Company

NORTH

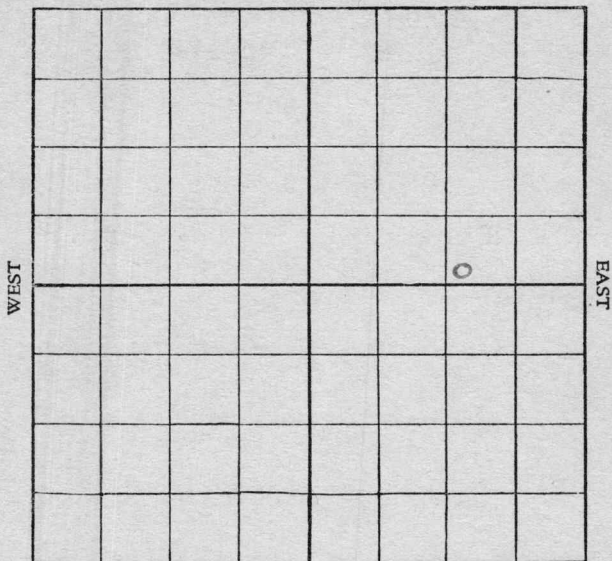

SOUTH

Location _____

Rig up _____

Drilling and remarks:

D.-2040'

RECORD

Cased _____ in. _____ Ft.

Sand _____

Gas _____

Oil _____

Total Depth _____

PRODUCTION

1st 24 hrs. Nat. _____

1st 24 hrs. after shot _____

Gas _____ Cu. Ft.

Dry Hole _____


Abandoned _____

Date JUL 7 1917

E. J. Crocker
 _____, 191_____, Scout

Map No. _____ Sec. 34 Twp. 26 R. 5Well No. 1 Kennedy Farm
Leonard Oil Company

NORTH

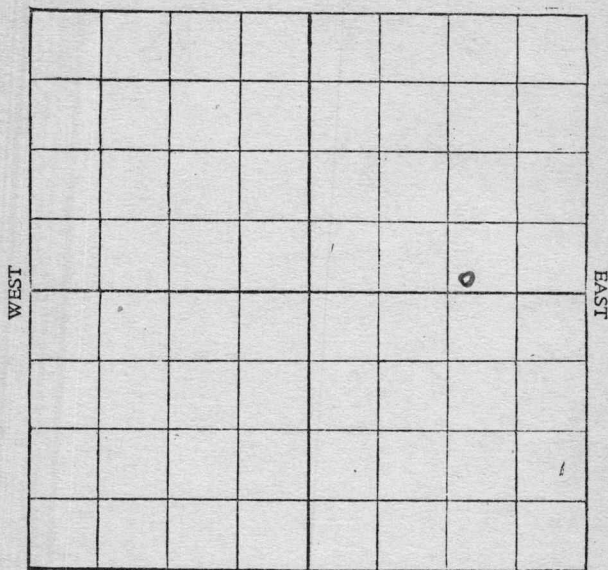

SOUTH

Location _____

Rig up _____

Drilling and remarks:

D-2110

RECORD

Cased _____ in. _____ Ft.

Sand _____

Gas _____

Oil _____

Total Depth _____

PRODUCTION

1st 24 hrs. Nat. _____

1st 24 hrs. after shot _____

Gas _____ Cu. Ft.

Dry Hole _____

Abandoned _____

Date

JUL 14 1917


191

C. J. Crocker Scout

Map No. _____ Sec. 34 Twp. 26 R. 5Well No. 1 Kennedy _____ FarmLeons _____ Company

NORTH

WEST

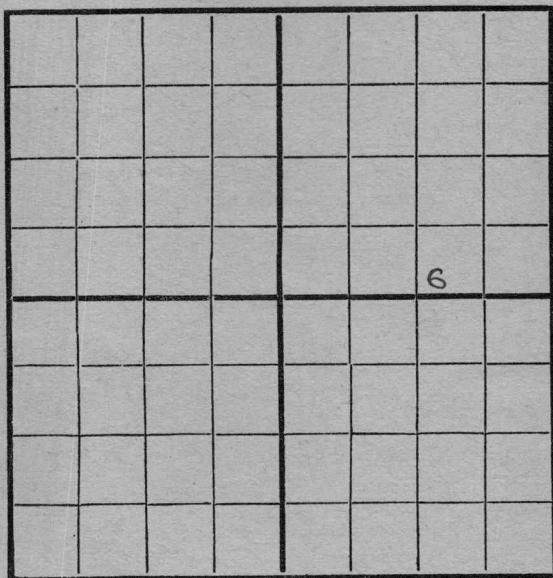

EAST

SOUTH

Location _____

Rig Up _____

Drilling and remarks

2329

RECORD

Cased _____ in. _____ Ft.

Sand _____

Gas _____

Oil _____

Total Depth _____

PRODUCTION

1st 24 hrs. Nat. _____

1st 24 hrs. after shot _____

Gas _____ Cu. Ft.

Dry Hole _____

Abandoned _____


Date

7/24, 191 7 Carliff Scout

Map No. _____ Sec. 34 Twp. 26 R. 5
 Well No. 1 Kennedy Farm _____
Leonard Oil Company

NORTH

WEST

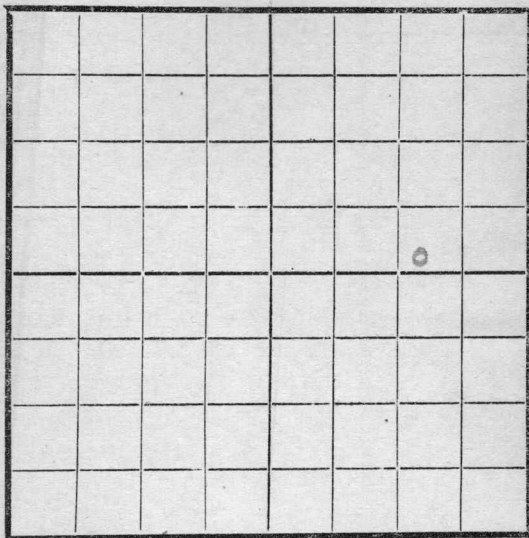

EAST

SOUTH

Location _____

Rig Up _____

Drilling and remarks

2740

RECORD

Cased _____ in. _____ Ft.

Sand _____

Gas _____

Oil _____

Total Depth _____

PRODUCTION

1st 24 hrs. Nat. _____

1st 24 hrs. after shot _____

Gas _____ Cu. Ft.

Dry Hole _____

Abandoned _____

Date


8/9, 1917 Conley Scout

Map No. _____ Sec. 34 Twp. 26 R. 5Well No. 1 Kennedy Farm _____

Company _____

NORTH

WEST

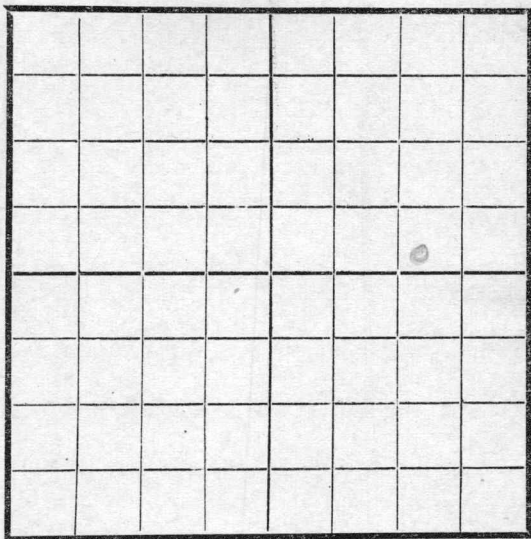

EAST

SOUTH

Location _____

Rig Up _____

Drilling and remarks

Shut Down
2740

RECORD

Cased _____ in. _____ Ft.

Sand _____

Gas _____

Oil _____

Total Depth _____

PRODUCTION

1st 24 hrs. Nat. _____

1st 24 hrs. after shot _____

Gas _____ Cu. Ft.

Dry Hole _____

Abandoned _____


Date

8/17, 191*7* *C. C. C.* Scout

Map No. _____ Sec. 34 Twp. 26 R. 5
 Well No. 1. Kunnis Fa _____
Leonard _____ Compa _____

NORTH

WEST

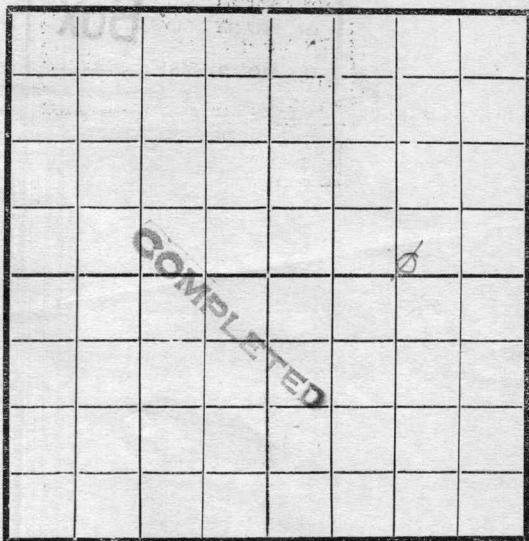

EAST

SOUTH

Location _____
 Rig Up _____
 Drilling and remarks _____

RECORD

Cased _____ in. _____ Ft.
 Sand _____
 Gas _____
 Oil _____
 Total Depth _____

PRODUCTION

1st 24 hrs. Nat. _____
 1st 24 hrs. after shot _____
 Gas _____ Cu. Ft.
 Dry Hole _____
 Abandoned 2808

Date

8-23-7 Lantz Scout