


Map No. Van Sec. 24 Twp. 25 R. 7

Well No. 1 Jones Farm _____
Liggett et al Company _____

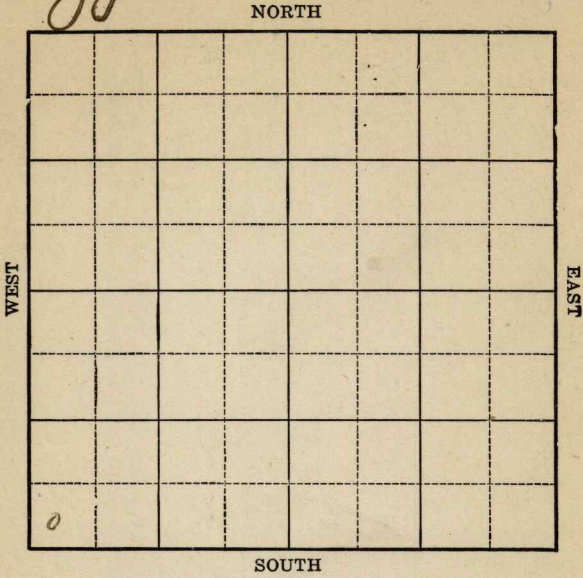

Location _____
Drilling Remarks _____

Rig Up _____
Drilling Remarks _____

RECORD

Cased _____ in. _____ ft.
Sand _____
Gas _____
Oil _____
Total Depth _____

PRODUCTION


1st 24 hrs. Nat. _____
1st. 24 hrs. after shot _____
Gas _____ cu. ft.
Dry Hole _____
Abandoned _____

Map No. *Kan* Sec. *24* Twp. *25* R. *7*Well No. *1* *Jones* Farm
Liggett et al Company

Ft. from N. Line

250 Ft. from S. Line

Ft. from E. Line

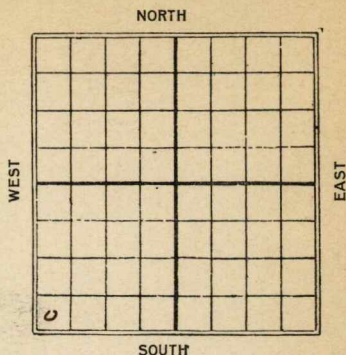250 Ft. from W. Line*C*

Date

REPORT

<i>1925</i>	
<i>7/17</i>	<i>Location</i>
<i>7/24</i>	
<i>7/31</i>	<i>Blk Ry</i>
<i>8/17</i>	<i>spnd.</i>
<i>8/14</i>	
<i>8/20</i>	
<i>8/27</i>	<i>950'</i>
<i>9/13</i>	<i>1500'</i>
<i>9/11</i>	<i>S.D. 1770'</i>
<i>9/16</i>	<i>1995'</i>
<i>9/24</i>	<i>2275'</i>
<i>10/1</i>	<i>2700'</i>
<i>10/8</i>	<i>2790'</i>
<i>10/16</i>	<i>Tap Line 2790 - 10/16 2900</i>
<i>10/29</i>	<i>Abandoned 3090'</i>

Map No. 15/1824 Sec. 24 Twp. 25 R. 7

Well No. 1 JONES

Liggitt Company

Contractor

FIRST REPORTS

SECTION PLAT

Ft. from N. Line

250 Ft. from S. Line

Ft. from E. Line

250 Ft. from W. Line

0			

Location ✓

Rig up

Drilling and Remarks:

RECORD

Cased _____ in., _____ ft.

Sand _____

Gas _____

Oil _____

Total Depth _____

PRODUCTION

1st 24 hrs. Nat. _____

1st 24 hrs. after shot _____

Gas _____ Cu. Ft.

Dry Hole _____

Abandoned _____

Date

JUL 17 1925

CHAS. L. SHERWOOD

192

Scout

Map No. *K15* **KANSAS** Sec. *24* Twp. *25* R. *7*

Well No. *1 Jones*
Liggelt of *AK* Company

Contractor

COMPLETED

SECTION PLAT

Ft. from N. Line

250

Ft. from S. Line

Ft. from E. Line

250

Ft. from W. Line

ABANDONED

Location

Rig up

Drilling and Remarks:

*Tap line 2790'**Dry & abo**L.D. 3090'*

RECORD

Cased _____ in., _____ ft.

Sand _____

Gas _____

Oil _____

Total Depth *3090'*

PRODUCTION

1st 24 hrs. Nat. _____

1st 24 hrs. after shot _____

Gas _____ Cu. Ft.

Dry Hole _____

Abandoned ☒

Date

OCT 29 1925

192

CHAS. L. SHERWOOD

Scout