

Section 34 Township 25 Range 10E

Well No. 1 Crocker

Company A. Anderson etal

Misc

NORTH

WEST

EAST

0							

SOUTH

Sec. 34 Twp. 25 R. 10E

Well No. #1 Crocker Farm

A. Anderson et al Company

Miscellaneous (Armstrong & Seader, Cont)


 Ft. from N. Line

200' Ft. from S. Line

 Ft. from E. Line

200' Ft. from W. Line

SW/c

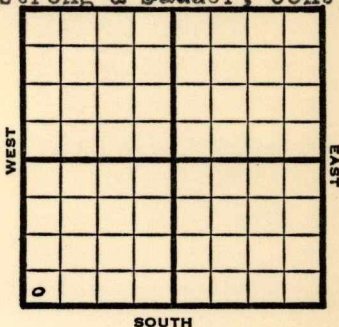

1949

REPORT

10/19 Spud
10/26 12" @ 28'
Drlg. 640'
11/1 10" @ 900 CO
11/9 Drlg 1260'
11/16 8" @ 1275'
Drlg 1924'
11/23 Miss 1976'
7" @ 1981'
11/30 TD 2057'
TD 2057'
Miss 1976'
7" @ 1981'
2000 acid
Pump 8 Oil Pot
38° Gr.
Comp

COMPLETED

Map No. _____ Sec. 34 Twp. 25 R. 10E

Well No. 1 Crocker

A. Anderson et al. Company

Armstrong & Sauder Contractor

FIRST REPORT
SECTION PLAT


SW/C

_____ Ft. from N. Line

200 Ft. from S. Line

_____ Ft. from E. Line

200 Ft. from W. Line

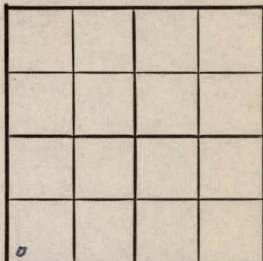

Greenwood County

Location _____

Rig up _____

Drilling and Remarks:

Spud

RECORD

Cased _____ in., _____ ft.

Sand _____

Gas _____

Oil _____

Total Depth _____

PRODUCTION

1st 24 hrs. Nat. _____

1st 24 hrs. after shot _____

Gas _____ Cu. Ft.

Dry Hole _____

Abandoned _____

Date

OCT 19 1949

19

S. J. LEWIS

Scout

Map No. _____ Sec. 34 Twp. 25 R. 10EWell No. 1 CrockerA. Anderson etal. Company**COMPLETE**

Contractor


SW/C

SECTION PLAT

_____ Ft. from N. Line

200 Ft. from S. Line

_____ Ft. from E. Line

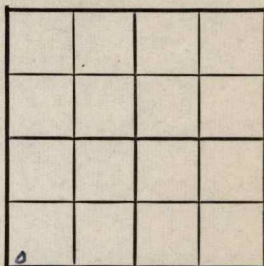200 Ft. from W. LineGreenwood County

Location _____

Rig up _____

Drilling and Remarks:

*Misc 1976**7" @ 1981**2000 acid**Pump Trail**38.5 ft*

RECORD

Cased _____ in., _____ ft.

Sand _____

Gas _____

Oil _____

Total Depth 2157

PRODUCTION

1st 24 hrs. Nat. _____

1st 24 hrs. after shot _____

Gas _____ Cu. Ft.

Dry Hole _____

Abandoned _____

Date

NOV 30 1949

19

S. J. LEWIS

Scout