


Map No. \_\_\_\_\_ Sec. 34 Twp. 25 R. 10

Well No. 1600 van Farm

Roan Eral Company

NORTH

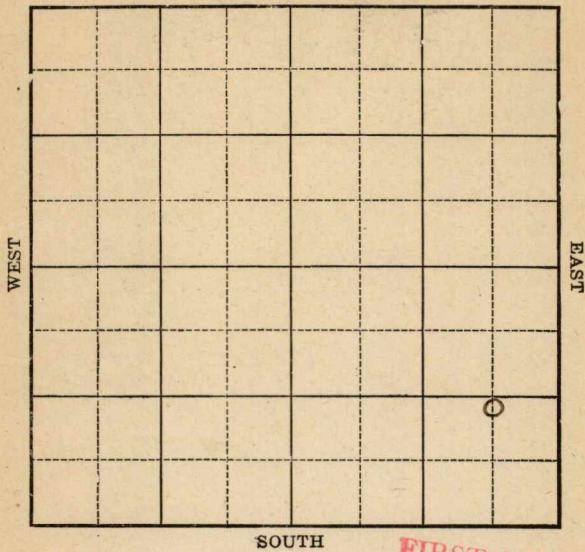

**FIRST REPORT**

Location \_\_\_\_\_

Rig Up

Drilling Remarks:

Drilling Remarks:

RECORD

Cased \_\_\_\_\_ in. \_\_\_\_\_ ft.

Sand \_\_\_\_\_

Gas \_\_\_\_\_

Oil \_\_\_\_\_

Total Depth\_\_\_\_\_

## PRODUCTION

1st 24 hrs. Nat. \_\_\_\_\_

1st 24 hrs. after shot\_\_\_\_\_

Gas \_\_\_\_\_ cu. ft.

Dry Hole \_\_\_\_\_

Abandoned \_\_\_\_\_

Map No. \_\_\_\_\_ Sec. 34 Twp. 25 R. 10


Well No. 1 Cocoran Farm \_\_\_\_\_  
Rogers Etal Company \_\_\_\_\_

\_\_\_\_\_ Ft. from N. Line

1120 Ft. from S. Line

660 Ft. from E. Line

\_\_\_\_\_ Ft. from W. Line

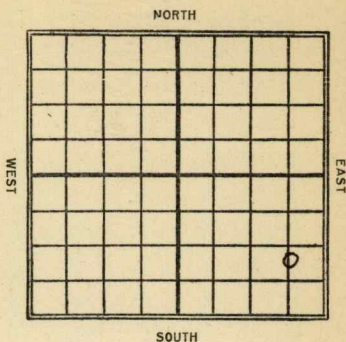

Date

REPORT

1922

10/26

Dlg. 900'

11/24

Sand 1952-85-Shot 20  
gls 45 Bbls.

Map No. KANSAS <sup>16</sup> Sec. 34 Twp. 23 R. 10Well No. 1 CooranRogers et al Company

Contractor

## FIRST REPORT

## SECTION PLAT

Ft. from N. Line

1120 Ft. from S. Line660 Ft. from E. Line

Ft. from W. Line

|  |  |  |  |
|--|--|--|--|
|  |  |  |  |
|  |  |  |  |
|  |  |  |  |
|  |  |  |  |

Location

Rig up

Drilling and Remarks:

9.00

## RECORD

Cased \_\_\_\_\_ in., \_\_\_\_\_ ft.

Sand \_\_\_\_\_

Gas \_\_\_\_\_

Oil \_\_\_\_\_

Total Depth \_\_\_\_\_

## PRODUCTION

1st 24 hrs. Nat. \_\_\_\_\_

1st 24 hrs. after shot \_\_\_\_\_

Gas \_\_\_\_\_ Cu. Ft.

Dry Hole \_\_\_\_\_

Abandoned \_\_\_\_\_

Date

OCT 26 1922M. A. BENEAR191

Scout



KANSAS

Map No. \_\_\_\_\_ Sec. 34 Twp. 25 R. 16Well No. 1 CochranRogers et al. Company

Contractor

COMPLETED

SECTION PLAT

|  |  |  |   |
|--|--|--|---|
|  |  |  |   |
|  |  |  |   |
|  |  |  |   |
|  |  |  | 0 |

Ft. from N. Line

1120 Ft. from S. Line660 Ft. from E. Line

Ft. from W. Line

## RECORD

Location \_\_\_\_\_

Cased \_\_\_\_\_ in., \_\_\_\_\_ ft.

Rig up \_\_\_\_\_

Sand \_\_\_\_\_

Drilling and Remarks:

Gas \_\_\_\_\_

Oil 1932-85Total Depth 1985

## PRODUCTION

1st 24 hrs. Nat. \_\_\_\_\_

1st 24 hrs. after shot 45

Gas \_\_\_\_\_ Cu. Ft.

Dry Hole \_\_\_\_\_

Abandoned \_\_\_\_\_

Date

NOV 24 1929

M. A. BENEAR Scout