

Sedgwick


KANSAS

SECTION 4 TOWNSHIP 27 RANGE 1E

WELL NO. #1 Willie Baker

COMPANY Shawver-Armour

NORTH

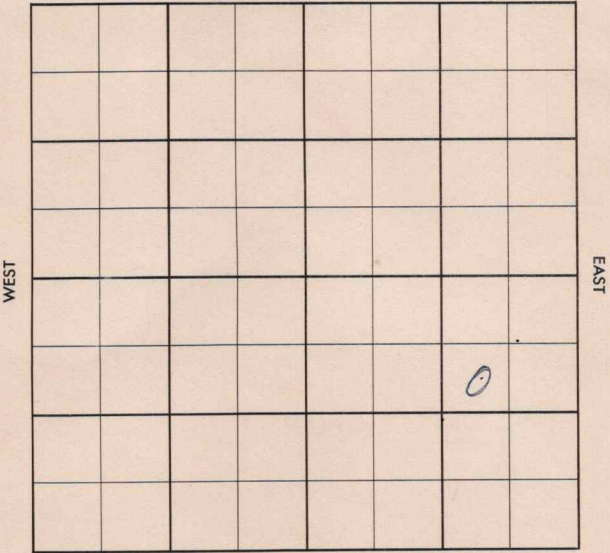

SOUTH

County Sedgwick Elev. _____
 Sec. 4 Twp. 27 Rge. 1E
 Company Shawver-Armour
 Farm Name Willie Baker No. 1

TOPS	DEPTH	LOG	DATUM	Loc. in Sec.
Anh.				SW NE SE
Tp.				
H.				
Tr.				
Dg.				
Bl.				
L.				Geol.
K.C.				Contr.
B.K.C.				
Ce.				
C.				
M.				Pool
M.				Wichita
K.				
Mz.				
Mq.				
V.				
S.				
S.				
A				
R.				
PE.				
G.				
T.D.				

FIRST REPORT
 DEC 28 '46

Date Comm.

MINT

29

County Sedgwick Elev. 1315
 Sec. 4 Twp. 27 Rge. 11
 Company Shaver-Armour
 Farm Name Willie Baker No. 1

TOPS	DEPTH	LOG	DATUM	Loc. in Sec.
Anh.				SW 11, SE
TP.				1800' FSL
H.				1100 FEET OF SEC
Tr.				Sec
Dg.				Geol.
BL.				Cantr.
L.				Pool
K.C.	2516			Wichita
B.K.C.				COMPLETE JUL 3 '57
Ce.				
C.				
M.	3001			
M.				
K.				
Mz.				
Mo.				
V.	3330			
S.				
S.				
A.				
R.				
Pe.				
G.				
T.D.	3333			

Date Comm.

STARTED 12-27-56 8 5/8 @

194/155 @ 2200

3215 DST 2518-35

45" rec 25' Md FP 0-0 BHP

18/20" DST 3326-31 90"

40' oil + 20' Md y oil FP 45-45

BHP 380/20 DST 3328-33 1 hr

2000' oil BHP 1285/ 5 1/2 3331

CO 3333 oil to surf.

90" P. 60 B0 + 27 BW in
12 hrs w. POT. FEB 13 '57

P. FEB 20 '57 FEB 27 '57 ✓ MAR 6 '57

MAR 13 '57 MAR 27 '57 APR 3 '57 APR 10 '57

APR 17 '57

P. 30 Bopd + 60 BW

pd. APR 24 '57 MAY 1 '57

P. 31 B0

+ 75 BW 24 hrs X

MAY 15 '57 MAY 22 '57 MAY 29 '57 JUN 5 '57 JUN 12 '57 JUN 19 '57

JUN 26 '57 JUL 3 '57

Ph P. 29 Bopd

+ 73 70 wtr grav 40°