


Section 9 Township 25 Range 9 E

Well No. # 1 Hendrickson

Company Stickle Drlg.

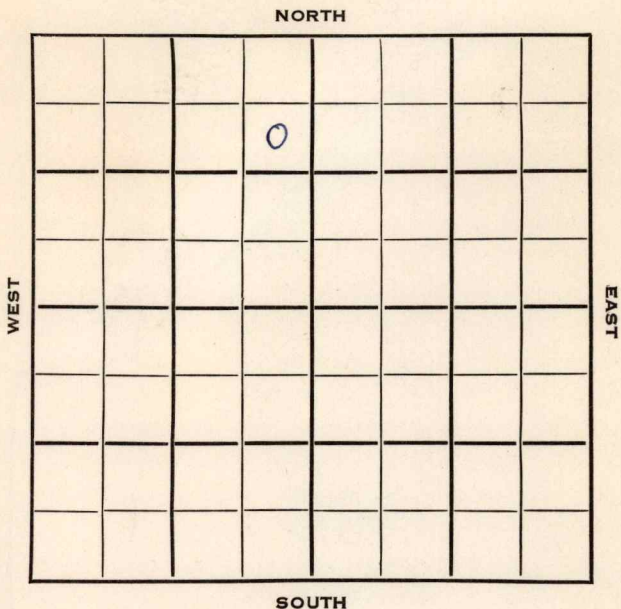

SEC.	TWP.	R.
9	25	9 E ✓

WELL NO.

1 Hendrickson

FARM

COMPANY

Stickle Drlg.

CONTRACTOR

White & Ellis


Thall-Sallyards Pool

990 Ft. from N. Line

Ft. from S. Line

330 Ft. from E. Line

Ft. from W. Line

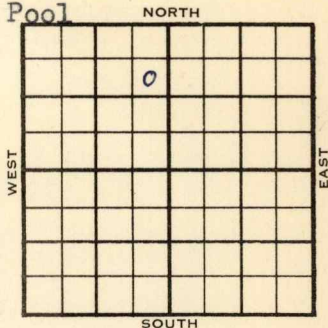

SE NE NW

ELEVATION

REPORT

1954

4/7 Spud 4-5-54

4/21 Spud 4-5-54

Oil Well

TD 2236'

8" @ 114'

KC 1490' Marm 1657', Cherokee 1909'

Bart 2110', L. Bart 2169'

TD 2236'

5" @ 2235'

CO to 2200'

60/ 2115-24 frac.

Comp 25 bopd.

COMPLETED

