

Greenwood

KANSAS


Form 51-5M-11-31-Palace

Map No. Sec. 9 Twp. 25 R. 9E

Well No. 1 Hendrickson Farm

E. J. Hooley Company

NORTH

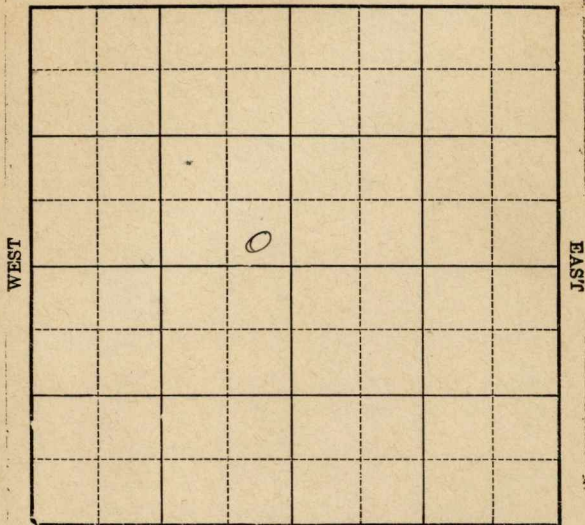

SOUTH

Location

Drilling Remarks

Rig Up

Drilling Remarks

RECORD

Cased in. ft.

Sand

Gas

Oil

Total Depth

PRODUCTION

1st 24 hrs. Nat.

1st 24 hrs. after shot

Gas cu. ft.

Dry Hole

Abandoned

Map No. _____ Sec. 9 Twp. 25 R. 9E

Well No. 1-Hendrickson Farm


E. J. Dooley Company

_____ Ft. from N. Line

250 Ft. from S. Line

250 Ft. from E. Line

_____ Ft. from W. Line

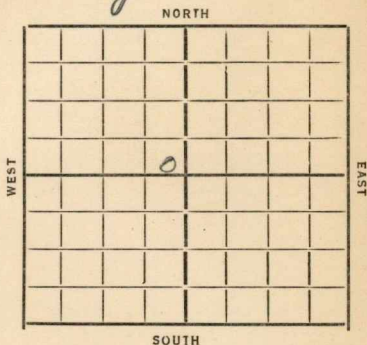

Date
1933

REPORT

8/16 Location

8/23 Rig up

8/30

9/6 Spud + S.D. 9/13 —

9/20 9/29 —

10/5

10/11 Sleg 850

10/18 S.Dat 1065

10/25 Sleg 1365

11/1 Shut down at 1400'

11/8 " " " 2200

11/15 Bartville 2111 - S.D. 2200

11/22 — 11/29 — 12/6 — 12/13 —

12/27 — 1/11 — 1/17 — 1/24 —

1/31 — 2/7 — 2/14 — 2/23 —

2/1 — 3/8 — 3/15 — 3/22 —

3/29 —

4/11 N 7 1/2 2165 TD 2170 Dr A

ABANDONED

Map No. 15 Sec. 9 Twp. 25 R. 9E
 Well No. 1-Hendrickson
E. J. Hooley Company
 Contractor

SECTION PLAT

.....Ft. from N. Line
250 Ft. from S. Line
250 Ft. from E. Line
Ft. from W. Line

FIRST REPORTS

Location.....
 Rig up.....
 Drilling and Remarks:

RECORD

Cased.....in.,ft.
 Sand.....
 Gas.....
 Oil.....
 Total Depth.....

PRODUCTION

1st 24 hrs. Nat.....
 1st 24 hrs. after shot.....
 Gas.....Cu. Ft.
 Dry Hole.....
 Abandoned.....

Date

8/16/33 192 O. Munnich Scout

Map No. 15 Sec. 9 Twp. 25 R. 9EWell No. 1-HendriksonE. J. Wooley Company


Contractor

SECTION PLAT

Ft. from N. Line

250 Ft. from S. Line250 Ft. from E. Line

Ft. from W. Line

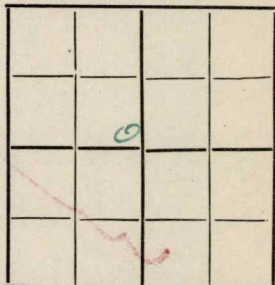

ABANDONED

Location

Rig up

Drilling and Remarks:

HFW 216510 + H

RECORD

Cased _____ in., _____ ft.

Sand _____

Gas _____

Oil _____

Total Depth 2170

PRODUCTION

1st 24 hrs. Nat. _____

1st 24 hrs. after shot _____

Gas _____ Cu. Ft.

Dry Hole _____

Abandoned _____

Date

HFW-34 192 O. Mannerhus Scout