


Map No. K14 Sec. 30 Twp. 26 R. 5

Well No. 49 Koogler Farm
Magnolia Pet Company

NORTH

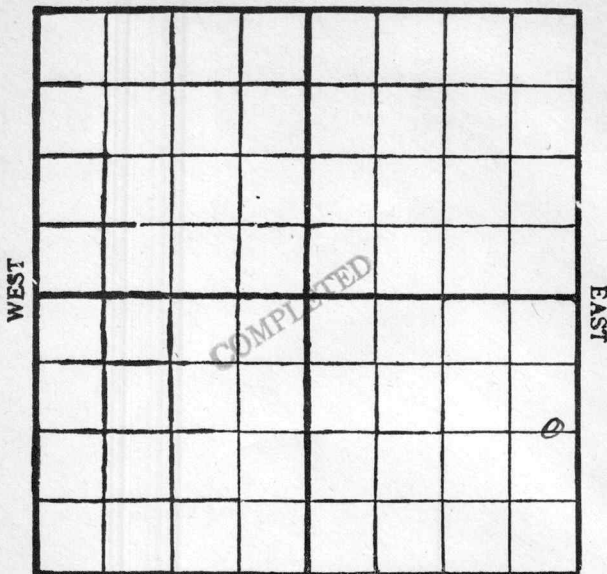

SOUTH

Location 1320 S 350 E

Drilling Remarks:

RECORD

Cased _____ in. _____ ft.
 Sand _____
 Gas _____
 Oil _____
 Total Depth _____

Rig Up _____

Drilling Remarks:

PRODUCTION

1st 24 hrs. Nat. _____
 1st 24 hrs. after shot _____
 Gas _____ cu. ft.
 Dry Hole _____
 Abandoned _____


Map No. K 14 Sec. 30 Twp. 26 R. 5^S 5^EWell No. 49 RooglerMagnolia Pet- Company

Contractor

NORTH

WEST

EAST

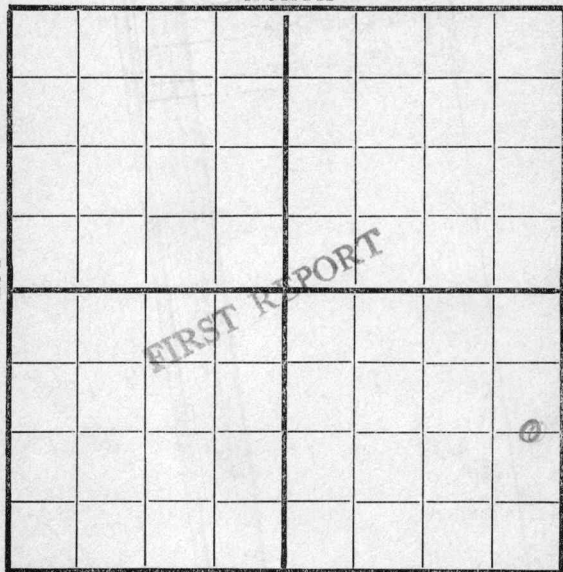

1320'S

SOUTH

350' E

Location _____

Rig up ☒

Drilling and Remarks:

RECORD

Cased _____ in., _____ ft.

Sand _____

Gas _____

Oil _____

Total Depth _____

PRODUCTION

1st 24 hrs. Nat. _____

1st 24 hrs. after shot _____

Gas _____ Cu. Ft.

Dry Hole _____

Abandoned _____

Date

Feb 6 1919Cyle Scout

Map No. K14 Sec. 30 Twp. 26 R. 5Well No. 49 RooglerMagnolia Jet Company

Contractor

NORTH

WEST

EAST

COMPLETED

SOUTH

1320 S

350 E

Location _____

Rig up _____

Drilling and Remarks:

RECORD

Cased _____ in., _____ ft.

Sand 2598-2608

Gas _____

Oil _____

Total Depth _____

PRODUCTION

1st 24 hrs. Nat. 75 bbls

1st 24 hrs. after shot _____

Gas _____ Cu. Ft.

Dry Hole _____

Abandoned _____

Date

5/7 1919 Pyle Scout