


Section 9 Township 25 Range 9 E

Well No. #2 Hendrickson

Company Stickle Drlg.

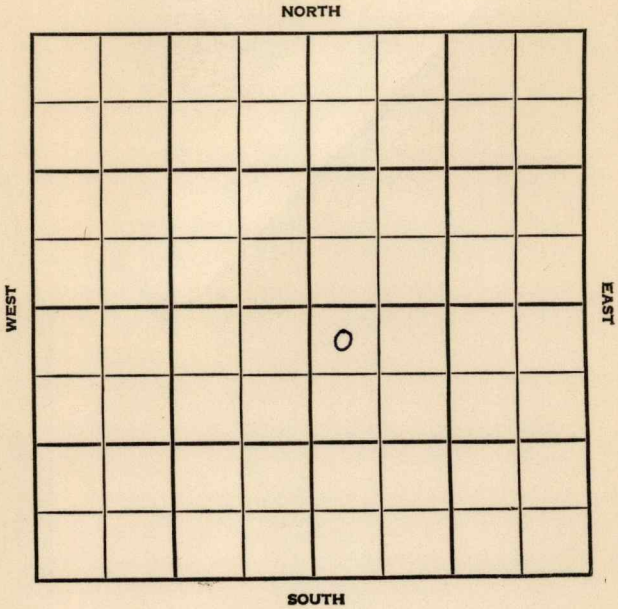

SEC.	9	TWP.	25	R.	9E
------	---	------	----	----	----

WELL NO. #2 Hendrickson FARM

COMPANY Stickle Drlg.


CONTRACTOR White & Ellis
Polhamus

_____ Ft. from N. Line

_____ Ft. from S. Line

_____ Ft. from E. Line

_____ Ft. from W. Line

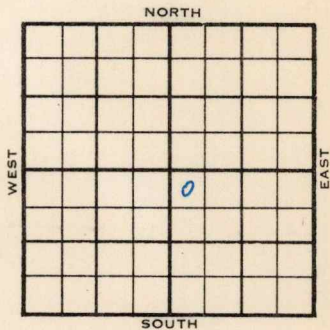

NW NW SE

1955	ELEVATION	REPORT
------	-----------	--------

10/5 W O R T

11/9

Comm 10-8-55
8 5/8" @ 95/80
4 1/2" @ 2218

~~Kc~~
Bart

1488
2141

TD 2220
frac Temp Abd.

ABANDONED

County Greenwood Elev. _____
 Sec. 9 Twp. 25 Rge. 9E
 Company Stickle Drig.
 Farm Name Hendrickson No. 2

TOPS	DEPTH	LOG	DATUM	Loc. in Sec.
Anh.				NW NW SE
TP.				
H.				
Tr.				
Dg.				
Bl.				
L.				Geol. _____
K.C.				Contr. _____
B.K.C.				White & Ellis
Ce.				
C.				Pool
M.				Polhamus
M.				
K.				
Mz.				
Me.				
V.				
S.				
S.				
A				
R.				
PE.				
G.				
T.D.				

FIRST REPORT
 OCT 5 '55

Date Comm. W O R T

Co.
 L.S.
 No.
 Sec.
 T.
 R.

County Greenwood Elev. _____
 Sec. 9 Twp. 25 Rge. 9E
 Company Stickle Drlg.
 Farm Name Hendrickson No. 2

TOPS	DEPTH	LOG	DATUM	Loc. in Sec. _____
Anh.				NW NW SE
TP.				
H.				
Tr.				
Dg.				
Bl.				
L.				
K.C.		<u>1488</u>		Geol. _____
B.K.C. <u>Bart</u>		<u>2141</u>		Contr _____
Ce.				<u>White & Elli</u>
C.				
M.				
M.				
K.				Pool _____
Mz.				<u>Polhamus</u>
Me.				
V.				
S.				
S.				
A.				
R.				
PE.				
G.				
T.D.	<u>2220</u>			

ABANDONED
 0

Date Comm. 10-8-55 NOV. 9 1955
8 5/8" @ 95/60 4 1/2" @ 2218 frac
 Temp. abd.

