


SECTION 9 TOWNSHIP 25S RANGE 9E

WELL NO. #2 Hendrickson

COMPANY J. H. Wagner (ElDorado)

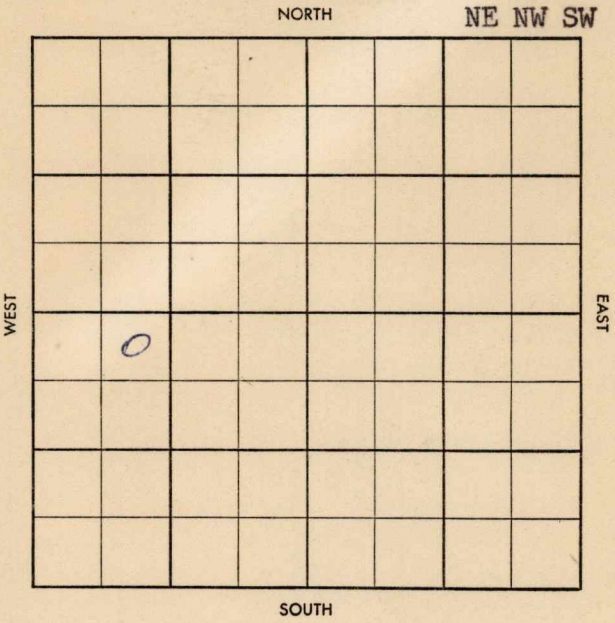

Twp. Pool
 Co. Facet

S-513-B

County Greenwood Elev. 1301 DF
 Sec. 9 Twp. 25 Rge. 9E
 Company J. M. Wagner (El Dorado)
 Farm Name Hendrickson No. 2

TOPS	DEPTH	LOG	DATUM
Anh.			
Tp.			
H.			
Tr.			
Dg.			
B.L.			
L.			
K.C.			
B.K.C.			
Ce.			
C. <u>Bant</u>	<u>2342-55</u>		
M.			
M.			
K.			
Mz.			
Mq.			
V.			
S.			
S.			
A.			
R.			
Pf.			
G.			
T.D.	<u>2355</u>		

Loc. in Sec. NE NW SW
 Geol. Polhamus
 Contr. Co. Tools
 Pool Polhamus
 COMPLETE
 JUN 18 '58

Date Comm. 5-19-58 12"170
 Location MAY 21 '58 Ø190 MAY 28 '58 Ø1350
JUN 1 '58 Ø2150 JUN 11 '58 5 1/2 2336
~~from~~ JUN 18 '58 ~~Ø~~ CO 2355
from pop est P 25 30 pd
+ tr w

