


Map No. _____ Sec. 10 Twp. 25 R. 9
 Well No. 1 Bland Farm _____
Natl. Ry. Co. Company _____

NORTH

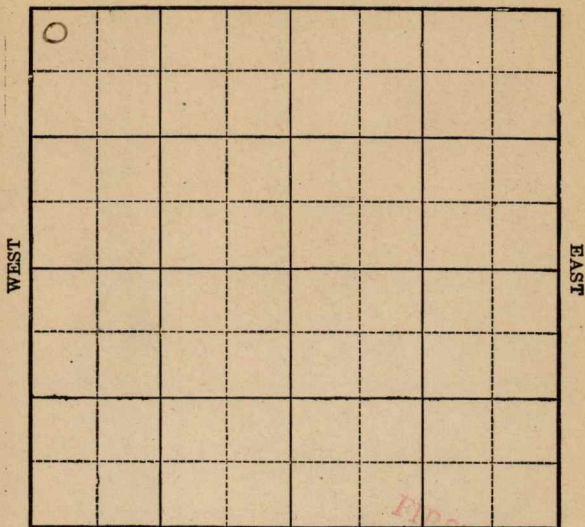

SOUTH

Location _____

Drilling Remarks:

Rig up _____

Drilling Remarks:

RECORD

Cased _____ in. _____ ft.

Sand _____

Gas _____

Oil _____

Total Depth _____

PRODUCTION

1st 24 hrs Nat. _____

1st 24 hrs. after shot _____

Gas _____ cu. ft.

Dry Hole _____

Abandoned _____

Map No. _____ Sec. 10 Twp. 25 R. 9


Well No. 1 Bland Farm
Natl. Rezg. Co. Company

200 Ft. from N, Line

Ft. from S. Line

Ft. from E. Line

200 Ft. from W. Line

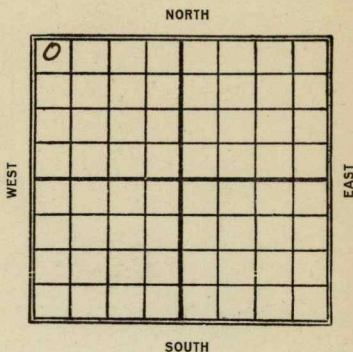

Date _____

REPORT

Date 1927

1/6	Rig & tools
-----	-------------

2/6	D. Ya. 2203
-----	-------------

KANSAS 15 To 25 9
 Map No. _____ Sec. _____ Twp. _____ R. _____

Well No. 1 Bland
 Nat'l Refg Co Company

Contractor _____

FIRST REPORT

SECTION PLAT

0			

200 Ft. from N. Line

_____ Ft. from S. Line

_____ Ft. from E. Line

200 Ft. from W. Line

Location _____

Rig up _____

Drilling and Remarks:

Rig & Tool

RECORD

Cased _____ in., _____ ft.

Sand _____

Gas _____

Oil _____

Total Depth _____

PRODUCTION

1st 24 hrs. Nat. _____

1st 24 hrs. after shot _____

Gas _____ Cu. Ft.

Dry Hole _____

Abandoned _____

Date

JAN 6 1923

M. A. BENEAR

191

Scout

Map No. **KANSAS** ¹⁵ Sec. 10 Twp. 25 R. 9

 Well No. 1 Bland
Nat'l Rwy Co. Company

Contractor

ABANDONED SECTION PLAT

200 Ft. from N. Line

_____ Ft. from S. Line

_____ Ft. from E. Line

200 Ft. from W. Line

0			

Location _____

Rig up _____

Drilling and Remarks:

Top line 2070'

RECORD

Cased _____ in., _____ ft.

Sand _____

Gas _____

Oil _____

Total Depth _____

PRODUCTION

1st 24 hrs. Nat. _____

1st 24 hrs. after shot _____

Gas _____ Cu. Ft.

Dry Hole _____

Abandoned 2203

Date

FEB 6 1923

M. A. BENEAR

191 _____

Scout