


Map No. Kansas Sec. 11 Twp. 25 R. 9
 Well No. 1 Wallace Farm
National Ref Company

NORTH

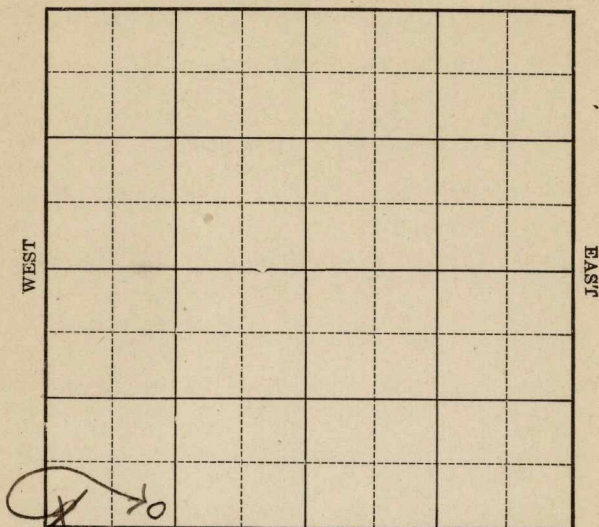

SOUTH

Location _____

Drilling Remarks _____

Rig Up _____

Drilling Remarks _____

RECORD

Cased _____ in. _____ ft.

Sand _____

Gas _____

Oil _____

Total Depth _____

PRODUCTION

1st 24 hrs. Nat. _____

1st 24 hrs. after shot _____

Gas _____ cu. ft.

Dry Hole _____

Abandoned _____

Greenwood Co
 Map No. 1 Kansas Sec. 11 Twp. 25 R. 9
 Well No. 1 Wallace Farm
National Refg Co Company

NORTH

WEST


EAST

SOUTH

Ft. from N. Line

200 Ft. from S. Line

Ft. from E. Line

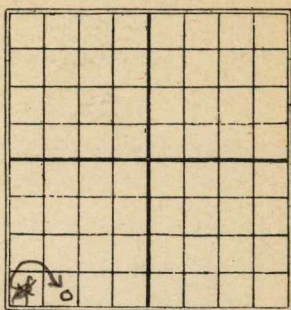1120
~~200~~ Ft. from W. Line

Date

REPORT

192511/27 Location

#

12/3 Correction ticket12/3 Turn hors.12/10 Block Refg12/17 Spudding12/20 Drilg 700'12/3119261/8 Drilg 1300'1/141/20 Top line 2260' U.R. 2325'1/272/42/10

Top Line 2260

Shale Break 2145-55

Top Line 2260-65

Sand 2417-50 H.F.W.

Shale 2680-90

Sand 2695-2700 H.F.W.

D. & G. 2700

K15 Map No. **KANSAS** Sec. *11* Twp. *25* R. *9*

Well No. *1* *Wallace*

National Bpp Co Company

Contractor

SECTION PLAT

_____ Ft. from N. Line

200 Ft. from S. Line

_____ Ft. from E. Line

200 Ft. from W. Line

FIRST REPORTS

Location *✓* _____
Rig up _____
Drilling and Remarks:

RECORD

Cased _____ in., _____ ft.
Sand _____
Gas _____
Oil _____
Total Depth _____

PRODUCTION

1st 24 hrs. Nat. _____
1st 24 hrs. after shot _____
Gas _____ Cu. Ft.
Dry Hole _____
Abandoned _____

Map No. KANSAS 15 Sec. 11 Twp. 25 R. 9

Well No. 1 Wallace
National Lfg Co Company

Contractor

SECTION PLAT

Ft. from N. Line

200 Ft. from S. Line

Ft. from E. Line

1120 Ft. from W. Line

CORRECTION

Location Timbers

Rig up

Drilling and Remarks:

chg location

to above.

RECORD

Cased _____ in., _____ ft.

Sand _____

Gas _____

Oil _____

Total Depth _____

PRODUCTION

1st 24 hrs. Nat. _____

1st 24 hrs. after shot _____

Gas _____ Cu. Ft.

Dry Hole _____

Abandoned _____

Date

DEC 3 1925

192

CHAS. L. SHERWOOD

Scout

Stonewood Co
 Map No. **K15 KANSAS** Sec. **11** Twp. **25** R. **9**

Well No. **1** *Waller*
Waller **Co.** Company

Contractor

COMPLETED

SECTION PLAT

Ft. from N. Line

200
 Ft. from S. Line

Ft. from E. Line

1120
 Ft. from W. Line

ABANDONED

o			

Location

Rig up

Drilling and Remarks:

Tap line 2260'
shale break 2145-55'
Red line 2260-65'
band 2417-50' AFW
shale 2680-90'
band 2695-2700' AFW
dry 2 hrs

RECORD

Cased _____ in., _____ ft.

Sand _____

Gas _____

Oil _____

Total Depth **2700 AFW**

PRODUCTION

1st 24 hrs. Nat. _____

1st 24 hrs. after shot _____

Gas _____ Cu. Ft.

Dry Hole ☒Abandoned ☒

Date

FEB 10 1926

CHAS. L. SHERWOOD

192

Scout